

Code H70

CODED

Tallahatchie
 H 30
 7-68 (H70)

MISSISSIPPI
 BOARD OF WATER COMMISSIONERS
 416 North State Street
 Jackson, Mississippi 39201

WATER WELL DRILLERS LOG

7-25-68 date well completed 19 Butane Gas Co. of G'wood firm name Tallahatchie county well located

LANDOWNER:
 Bayou Bend Country Club
 Webb, Miss.
 (mailing address)

WELL LOCATION:
 sec. 12 T. 24 N. R. 2 E
 W
1/2 miles nw of Webb
 (distance) (direction) (nearest town)


WELL PURPOSE: IRR
 (home, irrigation, municipal, industrial)

WELL COMPLETION DATA:

- (1) diameter (inches) 6"
- (2) total depth (feet) 1328
- (3) static water level (feet) 20 below top of ground.
- (4) casing Steel 1298
 (material) (depth)
6" x 3" if telescope see back.
 (size)
- (5) screen 30 1298
 (length) (depth to top)
3" Stainless Steel
 (size) (material)
- (6) pump 10 120
 (HP) (yield gpm)
Elec.
 (type power)
- (7) electric log no
 (yes or no)
- (8) how well bottom plugged
Back Pressure Drive

description of formations encountered	from	to
Clay	0	35
SAND	35	67
SAND + GRAVEL	67	124
Clay	124	131
SAND	131	184
Clay	184	326
SAND + SHALE	326	448
SHALE + ROCK	448	553
SHALE	553	682
SAND + SHALE	682	695
HARD PACKED SAND	695	738
SANDY SHALE	738	795
Clay + SHALE	795	800
SAND + SHALE	800	963
SHALE	963	984
Rock	984	986
Clay + SHALE	986	1115
SANDY SHALE	1115	1140
Clay + SHALE	1140	1149
SANDY SHALE	1149	1160
SAND + SHALE STREAKS	1160	1226
SHALE ROCK STREAKS	1226	1255
SANDY SHALE	1255	1282
Rock	1282	1283
SANDY SHALE	1283	1293
HARD PACKED SAND	1293	1334
SHALE	1334	1328

DRILLERS REMARKS: etc.

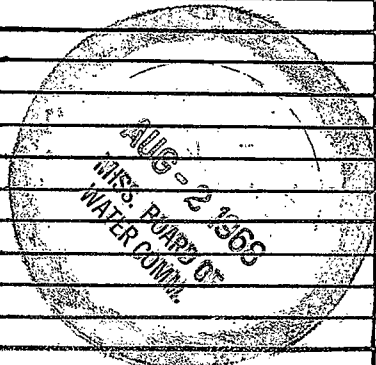

If well telescopes please sketch and show depths.

GROUND LEVEL

105' - 6"
CASING



1193' - 3"
CASING



20' - 13"

STAINLESS STEEL
SCREEN



	X		

SECTION 12

Please indicate well location X.

ADDITIONAL INFORMATION

If more than one screen, show locations of each on sketch.