

TALLAHATCHIE
H-89
7-10-80

MISSISSIPPI
BOARD OF WATER COMMISSIONERS
416 North State Street
Jackson, Mississippi 39201

CODED

WATER WELL DRILLERS LOG

7/10 1980 DYER WELL + IRR TALLAHATCHIE
date well completed firm name county well located

LANDOWNER:
B. A. MARLEY
SUMNER
(mailing address)

description of formations encountered	from	to
Clay	0	18
fine sand	18	28
sand	28	38
sand & gravel	38	103

WELL LOCATION:
sec. 2 T. 24 N. R. 2 E
S S W W
1/2 miles N of SUMNER
(distance) (direction) (nearest town)

WELL PURPOSE:
(home, irrigation, municipal, industrial)

WELL COMPLETION DATA:

(1) diameter (inches) 12"

(2) total depth (feet) 103

(3) static water level (feet) 19 below above top of ground.

(4) casing STEEL 63 (material) (depth)
12 (size) If telescope see back.

(5) screen 40 63 (length) (depth to top)
12 STEEL (size) (material)

(6) pump 20 1200 (HP) (yield gpm)
? (type power)

(7) electric log (yes or no)
(organization running log)

(8) how well bottom plugged STEEL PLATE

DRILLERS REMARKS:


DEPT. OF NATURAL RESOURCES
BUREAU OF LAND & WATER RESOURCES

SEP 18 1980

RECEIVED

If well telescopes please sketch and show depths.

GROUND LEVEL

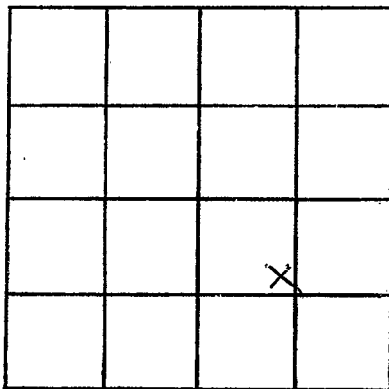

SECTION 2

Please indicate well location X.

ADDITIONAL INFORMATION

If more than one screen,
show locations of each on sketch.