

MISSISSIPPI DEPARTMENT OF NATURAL RESOURCES

Bureau of Land and Water Resources

Southport Mall

P.O. Box 10631

Jackson, Mississippi 39209

WATER WELL DRILLERS LOG

CODED

86112 KSE-01

Tallahatchie

N 54 1491

D-4686

April 22, 1986
date well completed

Dyer Well, Inc.
firm name

Tallahatchie
county well located

LANDOWNER: Thax Whitten
P.O. Box 523
Summer, Miss. 38957
(mailing address)

description of formations encountered

from

to

CLAY	0	48
FINE SAND	48	60
SAND + GRAVEL	60	95


WELL LOCATION:
sec. 9 T. 28 N. R. 2 E.
S. W.
2 1/2 miles East of Rome
(distance) (direction) (nearest town)

CODED

WELL PURPOSE: IRRIGATION
(home, irrigation, municipal, industrial)

WELL COMPLETION DATA:

- (1) diameter (inches) 12 3/4
- (2) total depth (feet) 95
- (3) static water level (feet) 22 below above top of ground.
- (4) casing STEEL, 65'
(material) (depth)
12 3/4" If telescope see back.
(size)
- (5) screen 40', 65'
(length) (depth to top)
12 3/4", Mild STEEL
(size) (material)
- (6) pump 30 1500
(HP) (yield gpm)
Electric
(type power)
- (7) electric log No
(yes or no)

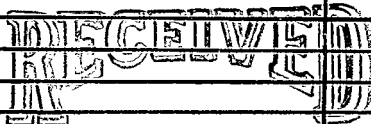

SEP 18 1986

Department of Natural Resources
Bureau of Land & Water Resources

(organization running log)


(8) how well bottom plugged PLATE

DRILLERS REMARKS:

86112 KSE-01

If well telescopes please
sketch and show depths.

GROUND LEVEL

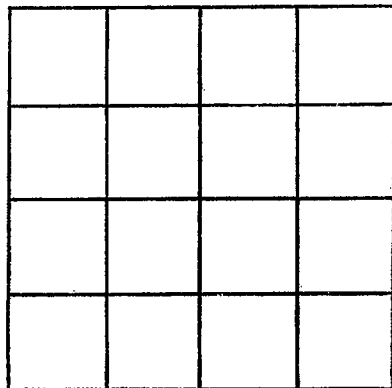

SECTION _____

Please indicate well location X.

ADDITIONAL INFORMATION

If more than one screen,
show locations of each on sketch.