

#1

State Well Report Part 1 - Driller's Log

Mississippi Department of Environmental Quality
Office of Land and Water Resources
P.O. Box 10631
Jackson, MS 39289-0631
(601)961-5210
(601)354-6938 (fax)

County: TALIAHATCHIE
 Permit #: 6W 40292
 Driller: HOUSTON
 Date drilling completed: 5/7

For Office Use Only:
 Aquifer: _____
 Well #: H-176
 L. S. Elevation: _____
 E-log #: _____

State Law requires that this report be prepared by the license holder responsible for the work and filed with the Department at the above address within 30 days of completion of drilling of the well or borehole.

Information on Well Owner (Landowner if borehole is not for a water well)	Well or Borehole Location
Owner Name: <u>RAY HAUSNER</u>	Latitude: <u>33° 54' 23" N</u> Longitude: <u>90° 22' 12" W</u>
Mailing Address: <u>WEBB MS</u> <u>511 SMOULBINE RD</u>	Method of Lat/Long (circle one): Conventional Survey, USGS quad, <u>Hand-held GPS</u> Survey-grade GPS
<u>Drew</u> <u>MS</u> <u>38737</u> City State Zip Code	<u>MW 1/4 SE 1/4 Sec 35</u> Twn <u>24N</u> Rng <u>2W</u>
Telephone No. <u>(662) 375-8764</u>	Distance _____ Direction _____ Nearest Town _____ Miles of _____

Well / Borehole Data

Date drilling started: 5/7 Date drilling completed: 5/7 Hole depth: 110 Hole diameter: 22

Location of the source of any surface water used for drilling: SAME

Method of dosing and volume of Chlorine used in drilling and development: 1 LB per 1000

Logs run (circle all applicable): No log run Electric Gamma Ray Density Sonic Neutron Other: _____

Name of organization running log(s): _____

Purpose of borehole (check one): Water Well Geotechnical/Geological Investigation _____ Ground Source Heat Pump _____

Seismic Survey _____ Other (describe) _____

If drilling is not related to water well construction, skip the remainder of this block

Purpose of Well (check one): Home _____ Industrial _____ Public Supply _____ Irrigation Fish Culture _____ Other: _____

If a flowing well, method of flow regulation: Valve _____ Other (describe) _____

Static Water Level: 28 feet above or below (circle one) land surface Date measured: 5/8

Method of Measurement (circle one) steel tape electric tape air line other: _____

Well depth: 110 Well grouted to a depth of 10 feet Type of grout (circle one): Neat Cement Bentonite Mix

Casing length: 70 feet Casing diameter: 12 inches Type of casing: PVC

Screen length: 40 feet Screen diameter: 12 inches Type of screen: PVC

Screen slot size: 0.30 inches Setting depth: From 70 feet to 110 feet

Type of completion (circle all applicable): Gravel packed Underreamed Telescoped Open hole Natural Development

Other (describe): _____

Top of lap pipe or reduction in casing: _____ feet. *If telescoped or more than one screen, describe on next page*

RECEIVED
SEP 12 2005
BY: OLWR

RECEIVED
JUL 28 2005
BY: OLWR

RECEIVED
JUL 28 2005
BY: OLWR

#1

H-176

The sketch below only required for water wells.

If well telescopes, show depths on sketch.


Ground Level _____

Description of formations encountered must be provided for all wells and boreholes, unless specifically exempted by regulations

Description of Formations Encountered	From (depth)	To (depth)
	Ground Level	
CLAY	0	13
FINE SAND	13	33
COURSE SAND	33	110
* GRAVEL		

If more than one screen, show location of each on sketch

Sketch the property layout and include the following: 1) the well location; 2) any permanent structures on the property that may aid in locating the well; 3) any roads, power lines, or other items that may aid in locating the property and the well; 4) a north arrow.

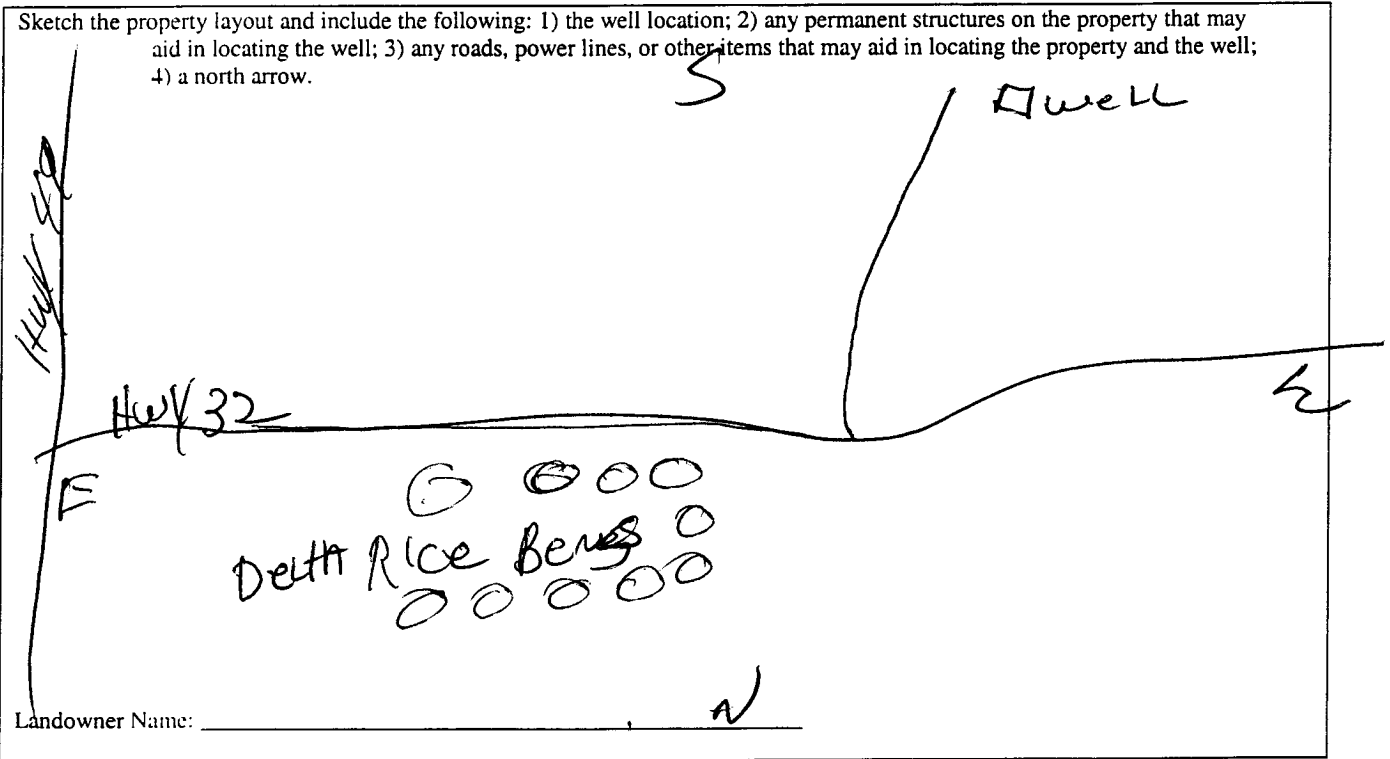

Landowner Name: _____

I certify that the well/borehole was drilled, constructed, and completed in accordance with all applicable requirements of the Mississippi Department of Environmental Quality and the Mississippi Department of Health regulations, if applicable, and state laws.

PAUL Powell 6955 **RECEIVED** 5/30/05 **RECEIVED** Paul Powell
 Print Name of Responsible Licensee and License No. Date Signature of Licensee

BY: OLWR **BY: OLWR**

#1

STATE WELL REPORT

Part 2

Pump Installer's Completion Report
 Mississippi Department of Environmental Quality
 Office of Land and Water Resources
 P.O. Box 10631
 Jackson, MS 39289-0631
 (601)961-5210
 (601)354-6938 (fax)

County: FA/IAhatchie
 Permit #: _____
 Driller: HOUSTON
 Date completed: 5/8
Copy information from block on Part 1

For Office Use Only:
 Aquifer: _____
 Well #: H-176
 Elevation: _____

This part of the report must be completed by a licensed water well contractor or a licensed pump installer. A copy of Part 1 of the report must be attached and both parts filed with the Department at the above address within 30 days of well completion.

Well Owner Information	Well Location
Owner Name: <u>RAY HAUSNER</u>	Latitude: <u>33° 54.23' N</u> Longitude: <u>090° 22.12' W</u>
Mailing Address: <u>WEBB MS</u> <u>511 SNOW BRAY RD</u>	Method of Lat/Long (check one): Conventional Survey _____ USGS quad _____, Hand-held GPS <input checked="" type="checkbox"/> , Survey-grade GPS _____
<u>Drew MS</u> City State Zip Code	_____ 1/4 _____ 1/4 Sec _____ T _____ R _____
Telephone No. <u>(662) 325-8764</u>	Distance Direction Nearest Town _____ Miles _____ of _____

Pump Type Circle one	Power Type Circle one
Air Lift Jet Submersible	<u>Diesel Engine</u> Gasoline Engine Natural Gas
Bucket Piston <u>Turbine</u>	Electric Motor Hand Tractor PTO
Centrifugal Rotary Flowing Well	Windmill Other (specify): _____
Other (specify): _____	Horse Power Rating of Motor: _____
Date Pump Installed: <u>5/8</u>	Setting Depth: <u>60</u> feet
Rated Pump Capacity: <u>1500</u> Gallons Per Minute	Number of Stages: <u>2</u>

Pump Test Data	Method of Measuring Water Level Circle one
Date Well Tested: _____	Air Line Electric Measuring Line <u>Steel Tape</u>
Static Water Level (A): <u>28</u> Feet Below Land Surface	Other (specify): _____
Pumping Water Level (B): _____ Feet Below Land Surface	For flowing well, measured shut in head: _____ feet
Drawdown [(B) - (A)]: _____ Feet Below Land Surface	Well yielded _____ GPM with a drawdown of _____ feet after _____ hours of pumping
Test Pumping Rate: _____ Gallons Per Minute	
Duration of Pump Test (minimum 4 hours): _____ hours	

I HEREBY CERTIFY that the above statements are true to the best of my knowledge.

PAUL POWELL
 Print Name of Pump Installer and License No. (if applicable)

Paul Powell
 Signature of Pump Installer

SEP 12 2005

BY: OLWR

JUL 28 2005

BY: OLWR