

MISSISSIPPI DEPARTMENT OF NATURAL RESOURCES

Bureau of Land and Water Resources

Southport Mall

P.O. Box 10631

CODED

Jackson, Mississippi 39209

WATER WELL DRILLERS LOG

TALLAHATCHIE
H178 ~~H43~~
3/2/83

3-7
date well completed

19 83

BUTANE GAS Co.

firm name

Tallahatchie

county well located

LANDOWNER:

B. A. Morley

description of formations encountered

from

to

Clay	0	25
Sand	25	45
sand & Gravel	45	93

(mailing address)

WELL LOCATION:

sec. 2 T ~~22~~ 24N R. 2 E
14 miles S of Sumner
(distance) (direction) (nearest town)

WELL PURPOSE:

Drinking
(home, irrigation, municipal, industrial)

WELL COMPLETION DATA:

(1) diameter (inches) 16"
(2) total depth (feet) 93
(3) static water level (feet) 20 below top of ground

(4) casing Steel, 53'
(material) (depth)
16" If telescope see back.
(size)

(5) screen 40, 53'
(length) (depth to top)
16", steel
(size) (material)

(6) pump 60, 1500
(HP) (yield gpm)
Diesel
(type power)

(7) electric log No
(yes or no)
No
(organization running log)

(8) how well bottom plugged
Steel plate

DRILLERS REMARKS:

Charles Roman


DEPT. OF NATURAL RESOURCES
BUREAU OF LAND & WATER RESOURCES

MAR 29 1983

RECEIVED

If well telescopes please sketch and show depths.

GROUND LEVEL

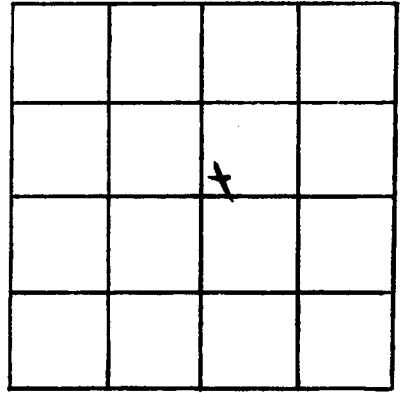

SECTION 2

Please indicate well location X.

ADDITIONAL INFORMATION

If more than one screen, show locations of each on sketch.