County:	Tallahatchie			
Permit#: <u>GW-41269</u> Irrigation Equipment Driller:				
Date dril	ling completed: 8-1-06			

State Well Report

Part 1

Mississippi Department of Environmental Quality Office of Land and Water Resources P.O. Box 10631 Jackson, MS 39289-0631 (601)961-5210 (601)354-6938 (fax)

For Office Use Only:			
Aquifer: #- 183			
L. S. Elevation:			
E-log #:			

State Law requires that this report be prepared by the driller in detail and filed with the Department within

30 days of completion of drilling of the well.	without in decima and mountain the one of the original and mountain the original and original an		
Well Owner Information	Well Location		
Owner Name Highland Plantation Mailing Address: 2250 Forest Hill	Latitude: 33 56 4.5.5" Longitude: 90 •23 31.2 Method of Lat/Long (circle one): Conventional Survey,		
	USGS quad, Hand-held GPS, Survey-grade GPS 14 NW 14 Sec 22 DTwn 24N RngW Distance Direction Nearest Town 3 Miles SW of Sumner		
. Well 1	Data		
Purpose of Well (circle one) Home Industrial Public Supply Date well drilling started: 8-1-06 Date w	Trigation Fish Culture Other:		
If flowing, method of flow regulation: Valve Other (d	escribe)		
Static Water Level:33'feet above or clow (circle one) l	and surface Date measured: 8-2-06		
Method of Measurement (circle one) steel tank electric tape Hole depth: 173 Well depth: 173 Type of grout (circle one): Cement Bentonite Mix			
Casing length: 73 feet Casing diameter: 10	inches Type of casing: PVC 160		
Screen length: 40 feet Screen diameter: 10			
Screen slot size:inches Setting depth: From _	74 feet to 113 feet		
Type of completion (circle all applicable): Gravel packet Underreamed Telescoped Open hole Natural Development			
Other (describe):			
Top of lap pipe or reduction in casing: feet. If tel	escoped or more than one screen, describe on back of page		
Logs run (circle all applicable): No log run Electric Gamma Ray Density Sonic Neutron Other:			
Name of organization running log(s):			
I certify that the well was drilled, constructed, and completed in accordance with all applicable requirements of the Mississippi			
Department of Environmental Quality and/or the Mississippi Department of Health regulations and state laws.			
Irrigation Equipment Inc. Patrick M. Chism 0695	Vatil MChi		
Print Name of Water Well Contractor and License No.	Signature of Water Well Contractor		

RECEIVED

AUG 2 3 2006


BY: OLWA

Ground Level

Description of Formations Encountered	From	То
	0	19
Clay Fine Sand Fine Sand/gravel Med. Sand/gravel	20	25
Fine Sand/gravel	26 36	135
Med. Sand/gravel	30	113
	 	\vdash
	_	\Box
		<u> </u>
		1
		↓ —-
		-
		┼┤
		+-
	 	+
		$\dagger \lnot \dagger$
		\perp
		┸

If more than one screen, show location of each on sketch

Sketch the property layout and include the following: 1) the well location; 2) any permanent structures on the property that may aid in locating the well; 3) any roads, power lines, or other items that may aid in locating the property and the well; 4) indicate direction.

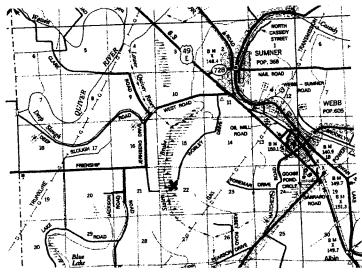

Landowner Name:	

Signature of Water Well Contractor

STATE WELL REPORT

Part 2

County: Tallahatchie

Irrigation Equipment

8-1-06

Permit #: 6W 41269

Date completed: _

Pump Installer's Completion Report
Mississippi Department of Environmental Quality
Office of Land and Water Resources
P.O. Box 10631
Jackson, MS 39289-0631
(601)961-5210
(601)354-6938 (fax)

For Office Use Only:			
Aquifer:	•		
Well #: # -	183		
Elevation:			

Copy information	n from block on Part I)-1-0736 (JAK)		
This part of the report must be completed by a licensed water well contractor or a licensed pump installer. A copy of Part 1 of the report must be attached and both parts filed with the Department at the above address within 30 days of well completion.					
	Well Owner Infor			Well Location	
Owner Name:	Highland Pla	intation	Latitude:	Longitude:	
Mailing Address	2250 Fores	t Hill	Method of Lat/Lo	ng (check one): Convention	nal Survey,
			USGS quad	Hand-held GPS, Surv	ey-grade GPS
		TN 38139	SE 1/2NW	% Sec 22 T 24N	R 2W
	City Sta	te Zip Code	Distance	Direction Nearest To	own
Telephone No. ()		3	SW of Sumner	İ
	Pump Type Power Type Circle one Circle one				
Air Lift	J et	Submersible	Diesel Engine	Gasoline Engine	Natural Gas
Bucket	Piston	Turbine	Electric Motor	Hand	Tractor PTO
Centrifugal	Rotary	Flowing Well	Windmill	Other (specify):	
Other (specify):	Other (specify): Horse Power Rating of Motor: 15				
Date Pump Instal	tate Pump Installed: 8-2-06 Setting Depth: 70 feet		_foct		
Rated Pump Cap	pacity: 750	Gallons Per Minute	Number of Stage:	s: <u>1</u>	
	Pump Test Da	ata	M	ethed of Measuring Wate	r Level
Date Well Tested	- đ:			Circle one	
Date Well Tested: Air Line Electric Measuring Line S Static Water Level (A): Feet Below Land Surface			Steel Tape		
• • • • • • • • • • • • • • • • • • • •			Other (specify):		
Drawdown [(B) - (A)]: Feet Below Land Surface For flowing well, measured shut in head: feet			feet		
Test Pumping Rate: Gallons Per Minute Well yielded GPM with a drawdown of					
Duration of Pump Test (minimum 4 hours):hourshours					
Duration of Pump	p Test (minimum 4 hot	rrs):hours		_fcet after	hours of pumping

I HEREBY CERTIFY that the above statements are true to the best	t of my kylojkijedeje.	RECEIVED
Patrick M. Chism 0695	Water Machine	. AUG 2 3 2006
Print Name of Pump Installer and License No. (if applicable)	Signature of Pump Installer	Section .
		FORD OF WIR-SMR-18