State W	ell Report	
	Part 1 For Office Use Only:	
	nt of Environmental Quality Aquifer:	
	and Water Resources Well #: #- /5/	
Driller:	Box 10631 AS 39289-0631 L. S. Elevation:	
1 0 1 1 1 1 1 1 1 1 1 1 1 1 1 1 1 1 1 1	961-5210	
(601)35	4-6938 (fax) E-log #:	
	1 20 1 1 2 2 2 2 2 2 2 2 2 2 2 2 2 2 2 2	
State Law requires that this report be prepared by the 30 days of completion of drilling of the well.		
Well Owner Information	Well Location 90 23.5 54.6	
Owner Name Highland Plantation	33 58 19.2N 90 23.5 54.6	
Owner Name 12550 Forest Hill Irene Road	Latitude: Longitude: SU	
Mailing Address:	Latitude:o, Longitude:o,, Method of Lat/Long (circle one): Conventional Survey,	
	USGS quad, Hand-held GPS, Survey-grade GPS	
Germantown TN 38139	14 SW 14 Sec 3 Twn 24N Rng 2W	
City State Zip Code	Distance Direction Nearest Town	
City Bate Zip Cote	2 Miles West of Sumner	
Telephone No. ()		
Well	Data	
Purpose of Well (circle one) Home Industrial Public Supply	Irrigation Fish Culture Other:	
Date well drilling started: 9-14-06 Date	well drilling completed: 9-14-06	
If flowing, method of flow regulation: Valve Other (c	describe)	
Static Water Level: 32' feet above of below (circle one)	land surface Date measured: 9-15-06	
Method of Measurement (circle one) steel tape electric tape	air line other:	
Hole depth: 117' Well depth: 117'	Well grouted to a depth of 10 feet	
Type of grout (circle one): Cement Bentomie Mix		
Casing length: 77 feet Casing diameter: 16	inches Type of casing: PVC Sch. 40	
Screen length: 40 feet Screen diameter: 16	inches Type of screen: PVC Sch. 40	
Screen slot size: <u>. 050</u> inches Setting depth: From	70	
Type of completion (circle all applicable): Gravel packed) Underreamed Telescoped Open hole Natural Development		
Other (describe):		
Top of lap pipe or reduction in casing:feet. If telescoped or more than one screen, describe on back of page		

Logs run (circle all applicable): No log run Electric Gamma Ray Density Sonic Neutron Other:

Department of Environmental Quality and/or the Mississippi Department of Health regulations and state laws.

I certify that the well was drilled, constructed, and completed in accordance with all applicable requirements of the Mississippi

Name of organization running log(s):

Patrick M. Chism

Print Name of Water Well Contractor and License No.

Irrigation Equipment Inc.

RECEIVED

Signature of Water Well Contractor

SEP 28 2006


BY: OLWF

Ground Level

Descr	iption of Formations Encountered	From	To
Clav		0	19
Fine	Sand Sand/gravel Sand/gravel	20	28
Fine :	Sand/gravel	29	62
Med.	Sand/gravel	63	117
		ļ. <u>.</u>	
		ļ	
		ļ	
			<u> </u>
			
		<u> </u>	
	····	<u> </u>	<u> </u>
		<u> </u>	
			$\vdash \vdash \vdash$
			
			1
		ļ	\vdash
		<u> </u>	
		<u> </u>	
		 	\vdash
		<u></u>	L

If more than one screen, show location of each on sketch

Sketch the property layout and include the following: 1) the well location; 2) any permanent structures on the property that may aid in locating the well; 3) any roads, power lines, or other items that may aid in locating the property and the well; 4) indicate direction.

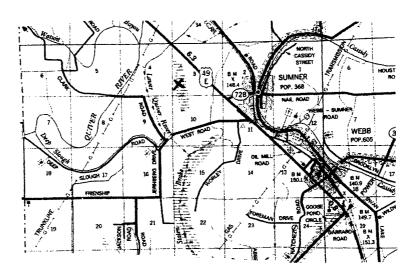

andowner Name:	

Signature of Water Well Contractor

STATE WELL REPORT

Tallahatchie County: Permit#: Irrigation Equipment Driller: 9-14-06

Part 2 Pump Installer's Completion Report
Mississippi Department of Environmental Quality
Office of Land and Water Resources P.O. Box 10631 Jackson, MS 39289-0631

For Office Use Only:	
Aquifer:	•
Wdl#: H	.184
Elevation:	

Copy information from block on Part 1	(601)961-5210 (601)354-6938 (fax) Elevation:
	ter well contractor or a licensed pump installer. A copy of Part 1 of the riment at the above address within 30 days of well completion.
Well Owner Information	Well Location
Owner Name: Highland Plantation	Latitude: Longitude:
2550 Forest Hill Irene Road	Method of Lat/Long (check one): Conventional Survey,
	USGS quad, Hand-held GPS, Survey-grade GPS
Germantown TN 38139 City State Zip Code	NW 1/2 SW 1/4 Sec 3 T 24N R 2W
City State Zip code	Distance Direction Nearest Town
Telephone No. ()	2 Miles West of Sumner
Pump Type	Power Type
Circle one	Circle one
Air Lift Jet Submersible	Diesel Engine Gasoline Engine Natural Gas
Bucket Piston Turbine	Electric Motor Hand Tractor PTO
Centrifugal Rotary Flowing Well	Windmill Other (specify):
Other (specify):	Horse Power Rating of Motor: 60
Date Pump Installed: 9-15-06 2500-3000	Setting Depth: 70 feet
Rated Pump Capacity:Gallons Per Minu	vite Number of Stages: 1
Pump Test Data	Method of Measuring Water Level Circle one
Date Well Tested:	Circle one
Static Water Level (A):Feet Below Land Surfa	
Pumping Water Level (B):Feet Below Land Surfa	Other (specify):
Drawdown [(B) -(A)]:Feet Below Land Surfi	For flowing well, measured shut in head:feet
Test Pumping Rate: Gallons Per Minu	ute Well yieldedGPM with a drawdown of
	ars feet after hours of pumping

I HEREBY CERTIFY that the above statements are true to	the best of my knowledge.
Patrick M. Chism 0695	Patrix M chin
Print Name of Pump Installer and License No. (if applicable	e) Signature of Pump Installer

SEP 28 2006