State Well Report					
County: Tallahatchie Part 1 For Office Use Only:					
Mississippi Department of Environmental Quality Aquifer:	_				
Permit #: Office of Land and Water Resources Irrigation Equipment P.O. Roy 10631 Well #: H-185	_ [
Driller: Jackson MS 39289-0631					
Date drilling completed: 3-10-07 (601)961-5210	-				
(601)354-6938 (fax) E-log #:	_				
State Law requires that this report be prepared by the driller in detail and filed with the Department within					
30 days of completion of drilling of the well. Well Owner Information Well Location					
33 58 44.5 90 25 27.0W					
Owner Name Farmers National Company 622 West Poplar Suite 5 33 58 44.5 90 25 27.0W Latitude: " Longitude: " Longitude: " Longitude: " 27	'				
Mailing Address: 622 West Poplar, Suite 5 Method of Lat/Long (circle one): Conventional Survey,					
PMB 357 USGS quad, Hand-held GPS, Survey-grade GPS					
Collierville TN 38017 SW % Sec 5 / Twn 24N Rng 2W					
City State Zip Code Distance Direction Nearest Town	- 1				
Telephone No. () 3 Miles South of Tutwiler	-				
Telephone No. ()	1				
Well Data					
Purpose of Well (circle one) Home Industrial Public Supply Irigation Fish Culture Other:					
Date well drilling started: $3-10-07$ Date well drilling completed: $3-10-07$					
If flowing, method of flow regulation: Valve Other (describe)					
Static Water Level: 36' feet above of below (circle one) land surface Date measured: 3-10-07					
Method of Measurement (circle one) steel take electric tape air line other:					
Hole depth: 123 Well depth: 123 119 Well grouted to a depth of 10 feet					
Type of grout (circle one): Cement Bentonic Mix					
Casing length: 83 79 feet Casing diameter: 12 inches Type of casing: PVC160					
Screen length: 40 feet Screen diameter: 12 inches Type of screen: PVC160					
Screen slot size:050 inches Setting depth: From7\qquad 80 feet to119 feet					
Type of completion (circle all applicable): Gravel packet Underreamed Telescoped Open hole Natural Development					
Other (describe):					
Top of lap pipe or reduction in casing feet. If telescoped or more than one screen, describe on back of page					
Logs run (circle all applicable): No log run Electric Gamma Ray Density Sonic Neutron Other:					
Name of organization running log(s): I certify that the well was drilled, constructed, and completed in accordance with all applicable requirements of the Mississipp	i I				
Name of organization running log(s): I certify that the well was drilled, constructed, and completed in accordance with all applicable requirements of the Mississipp Department of Environmental Quality and/or the Mississippi Department of Mealth regulations and state laws.	i				

Print Name of Water Well Contractor and License No.

RECEIVED


Signature of Water Well Contractor

MAR 3 0 2007

Ground Level

Description of Formations Encountered	From_	To
Clay	0	38_
Fine Sand	39	43
Fine Sand/gravel	44	52
Fine Sand/gravel Med. Sand/gravel Fine Sand	53	119
Fine Sand	120	123
	ļ	
	ļ	<u> </u>
	₩	1
		
	 	
	 	\vdash
	 -	╀
	 	-
	 	
	 	\vdash
	+	\vdash
	╂	-
	-	\vdash
	+	\vdash
	+	+-+
	+	┼─┤
	+	+-
	+-	+

If more than one screen, show location of each on sketch

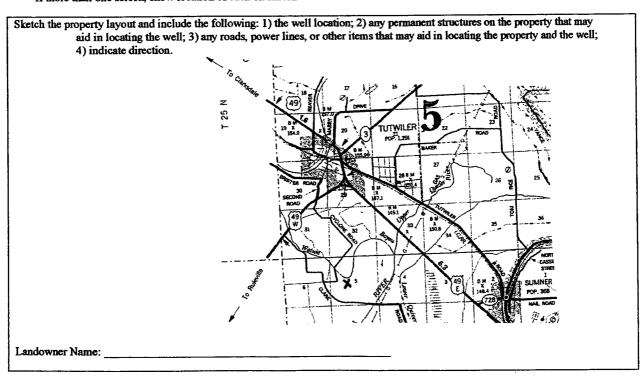

Signature of Water Well Contractor

STATE WELL REPORT

County:____Tallahatchie Permit#:___ Irrigation Equipment Date completed:____3-10-07

Part 2
Pump Installer's Completion Report
Mississippi Department of Environmental Quality
Office of Land and Water Resources
P.O. Box 10631

P.O. Box 10631 Jackson, MS 39289-0631 (601)961-5210 (601)354-6938 (fax)

For Office Use Only:		
Aquifer:		
Well#: H-185		
Elevation:		

(601,53	74-0536 (IAX)			
This report should be prepared by the pump installer in deta installation of pump.	ail and filed with the Department within 30 days of the			
Well Owner Information	Well Location			
Owner Name: Farmers National Company	Latitude:Longitude:			
Mailing Address: 622 West Poplar, Suite 5	Method of Lat/Long (circle one): Conventional Survey,			
PMB 357	USGS quad, Hand-held GPS, Survey-grade GPS			
Collierville TN 38017 City State Zip Code				
901-850-1203	Distance Direction Nearest Town			
Telephone No. ()	3 Miles South of Tutwiler			
Pump Type	Power Type			
Circle one	Circle one			
Air Lift Jet Submersible	Diesel Engine Gasoline Engine Natural Gas			
Bucket Piston Turbine	Electric Motor Hand Tractor PTO			
Centrifugal Rotary Flowing Well	Windmill Other (specify):			
Other (specify):	Horse Power Rating of Motor: 30			
Date Pump Installed: 3-10-07	Setting Depth: 70 feet			
Rated Pump Capacity: 1400± Gallons Per Minute	Number of Stages: 2			
Pump Test Data	Method of Measuring Water Level			
•	Circle one			
Date Well Tested:	Air Line Electric Measuring Line Steel Tape			
Static Water Level (A):Feet Below Land Surface	Other (specify):			
Pumping Water Level (B): Feet Below Land Surface	Colorado de Colora			
Drawdown [(B)-(A)]:Feet Below Land Surface	For flowing well, measured shut in head:feet			
Test Pumping Rate:Gallons Per Minute	Well yieldedGPM with a drawdown of			
Duration of Pump Test (minimum 4 hours):hours	feet after hours of pumping			

I HEREBY CERTIFY that the above statements are true to the best of	my mwigitge.	hard here by hom 27 home has
Patrick M. Chism 0695	Patris In Q	- RECEIMEL
Print Name of Pump Installer and License No. (if applicable)	Signature of Pump Installer	700 0 0 0 0 0 0 0 0 0 0 0 0 0 0 0 0 0 0
		VUUZ G C MAIN