

County: Tallahatchie
 Permit #: GW43174
 Driller: Irrigation Equipment
 Date drilling completed: 4/29/09

State Well Report

Part 1

Mississippi Department of Environmental Quality
 Office of Land and Water Resources
 P.O. Box 10631
 Jackson, MS 39289-0631
 (601)961-5210
 (601)354-6938 (fax)

For Office Use Only:
 Aquifer: _____
 Well #: H-192
 L. S. Elevation: _____
 E-log #: _____

State Law requires that this report be prepared by the driller in detail and filed with the Department within 30 days of completion of drilling of the well.

Well Owner Information	Well Location
Owner Name: <u>Jerry Armstead</u>	Latitude: _____ Longitude: _____
Mailing Address: <u>227 Sumner, Hwy 321</u>	Method of Lat/Long (circle one): <input type="radio"/> Conventional Survey, <input type="radio"/> USGS quad, <input type="radio"/> Hand-held GPS, <input type="radio"/> Survey-grade GPS
<u>Tutwiler</u> Ms. <u>38963</u>	<u>NE 1/4 NW 1/4</u> Sec <u>18</u> Twn <u>24N</u> Rng <u>2W</u>
City State Zip Code	Distance Direction Nearest Town
Telephones No. () _____	<u>2</u> Miles <u>SE</u> of <u>Rome</u>

Well Data

Purpose of Well (circle one) Home Industrial Public Supply Irrigation Fish Culture Other: _____

Date well drilling started: 4/29/09 Date well drilling completed: 4/29/09

If flowing, method of flow regulation: Valve _____ Other (describe) _____

Static Water Level: 37 feet above or below (circle one) land surface Date measured: 4/30/09

Method of Measurement (circle one) steel tape electric tape air line other: _____

Hole depth: 125 Well depth: 125 Well grouted to a depth of 10 feet

Type of grout (circle one): Cement Bentonite Mix

Casing length: 85 feet Casing diameter: 16 inches Type of casing: PVC

Screen length: 40 feet Screen diameter: 16 inches Type of screen: PVC

Screen slot size: .050 inches Setting depth: From 86 feet to 125 feet

Type of completion (circle all applicable): Gravel packed Underreamed Telescoped Open hole Natural Development

Other (describe): _____

Top of lap pipe or reduction in casing: _____ feet. If telescoped or more than one screen, describe on back of page

Logs run (circle all applicable) No log run Electric Gamma Ray Density Sonic Neutron Other: _____

Name of organization running log(s): _____

I certify that the well was drilled, constructed, and completed in accordance with all applicable requirements of the Mississippi Department of Environmental Quality and/or the Mississippi Department of Health regulations and state laws.

Irrigation Equipment Inc.
 John P. Chism 0439

Print Name of Water Well Contractor and License No. _____

Signature of Water Well Contractor John P. Chism

RECEIVED
 MAY 05 2009
 BY: OLWR

STATE WELL REPORT

Part 2

Pump Installer's Completion Report
 Mississippi Department of Environmental Quality
 Office of Land and Water Resources
 P.O. Box 10631
 Jackson, MS 39289-0631
 (601)961-5210
 (601)354-6938 (fax)

County: Tallahatchie
 Permit #: _____
 Irrigation Equipment
 Driller: _____
 Date completed: 4/29/09

For Office Use Only:

Acquifer: _____
 Well #: H-192
 Elevation: _____

This report should be prepared by the pump installer in detail and filed with the Department within 30 days of the installation of pump.

Well Owner Information	Well Location
Owner Name: <u>Jerry Armstead</u>	Latitude: _____ Longitude: _____
Mailing Address: <u>227 Sumner to Hwy 321 Rd</u>	Method of Lat/Long (circle one): Conventional Survey,
<u>Tutwiler Ms. 38963</u>	USGS quad, Hand-held GPS, Survey-grade GPS.
City State Zip Code	<u>NE 1/4 NW 1/4 Sec 18 Twn 24N Rng 2W</u>
Telephone No. () _____	Distance Direction Nearest Town
	<u>2 Miles SE of Rome</u>

Pump Type Circle one	Power Type Circle one
Air Lift Jet Submersible	Diesel Engine Gasoline Engine Natural Gas
Bucket Piston <u>Turbine</u>	<u>Electric Motor</u> Hand Tractor PTO
Centrifugal Rotary Flowing Well	Windmill Other (specify): _____
Other (specify): _____	Horse Power Rating of Motor: <u>60</u>
Date Pump Installed: <u>4/30/09</u>	Setting Depth: <u>70</u> feet
Rated Pump Capacity: <u>2300 ±</u> Gallons Per Minute	Number of Stages: <u>2</u>

Pump Test Data	Method of Measuring Water Level Circle one
Date Well Tested: _____	Air Line Electric Measuring Line Steel Tape
Static Water Level (A): _____ Feet Below Land Surface	Other (specify): _____
Pumping Water Level (B): _____ Feet Below Land Surface	For flowing well, measured shut in head: _____ feet
Drawdown [(B) - (A)]: _____ Feet Below Land Surface	Well yielded _____ GPM with a drawdown of
Test Pumping Rate: _____ Gallons Per Minute	_____ feet after _____ hours of pumping
Duration of Pump Test (minimum 4 hours): _____ hours	

I HEREBY CERTIFY that the above statements are true to the best of my knowledge.

John P. Chism 0439
 Print Name of Pump Installer and License No. (if applicable)

John P. Chism
 Signature of Pump Installer


RECEIVED

MAY 05 2009

BY: OLWR

- HIGH RD. C3
- HIGHPOINT RD. D4,D6
- HILL RD. C3
- KITTSBUR RD. C2
- HOLLAND TILLATOBA RD. C6
- HOLLAND DR. D2
- HOLLY GROVE RD. B4
- HOPSON BAYOU RD. B2
- HORSESHOE BRAKE DR. D2
- HOUSE RD. INSET A
- HOUSTON RD. C3
- HOWARD RD. A6
- HUNTER CREEK RD. B6
- HYDE RD. B4
- ISLAND RD. D4
- JACKSON AVE INSET A
- JACKSON GROVE DR. A5
- JACKSON RD. C2
- JAMES RD. A6
- JENKINS RD. B3,C2
- JENNINGS DR. D4
- JERNBERG DR. C2
- JORDAN HILL RD. B6,C6,C6
- KING RD. A6
- LAKESIDE DR. C6
- LANE RD. D6
- LANG DR. C6
- LEVEE RD. A5,B4,B6
- LEVERETTE LANE D4,D6
- LITTLE HUBBARD RD. C3
- LITTLE RD. B6
- LONG RD. B8,B4
- LOUNGE RD. C3
- LUCKETT RD. B2
- MABUS RD. D4,E4
- MACKAY DR. C3
- MAANNING DR. B6
- MARSHALL DR. D6
- MCCULLOUGH DR. C4
- MCKINLEY AVE. A3
- MCNULTY RD. B5,B3
- MELTON RD. B4,B8
- MILAM LANE C6
- MITCHELL LAKE RD. C4
- MITCHELL RD. C6
- MITCHENER RD. B3
- MONEY RD. E4
- MORNING STAR DR. C4
- MORRIS DR. D2
- MORROW RD. D2
- MOSIER RD. A5,A6
- MT. OLIVE RD. C6
- MT. PISGAH RD. A6
- MABUS RD. D4,E4
- MUDLINE RD. A6
- MURPHY DR. C4
- MURPHREESBORO RD. C6
- NATCHEZ RD. C2
- NATIONS RD. C4
- NED RICE RD. B6
- NELSON RD. B6
- NEW HOPE RD. C6
- NEWMAN DR. A5
- NORTH CASSIDY ST. C2
- NORTH CREEK RD. B6
- OAK GROVE RD. B6
- OAKLAND - ENID RD. A6
- ORRELL DR. D6
- OTTER LAKE DR. C4
- PADUCAH WELLS RD. B6
- PAMPLIN RD. C4
- PATTERSON LAKE ROAD C4
- PAUL - SHADY GROVE RD. C6,D6
- PEARSON RD. C2
- PETERS HILL ROAD A5
- PHARIS RD. B2
- PICKLE RD. INSET A
- PINE HILL CHURCH RD. A6,B6
- PINE HILL RD. B6
- POWERS CREEK RD. D6
- PRESSGROVE RD. D6,D6
- PROVIDENCE RD. C6
- PUMPING STATION RD. C6
- RABBIT RIDGE RD. C4,D4
- RAILROAD RD. C4,D4
- RAINEY DR. A5
- REDD DRIVE B3
- RIVER ROAD D3,D4
- ROCKY BRANCH RD. B6
- ROSELoom RD. C6,D6
- ROUNSAVILLE DR. B6
- ROWE DR. A6
- RUFFIN RD. A6
- SANDERS RD. A6
- SANDY BAYOU RD. D2
- SANDY CREEK DR. A6
- SCALLIONS ROAD D6
- SECOND ST. E4
- SECOND ST. EXT. TUTWI B2
- SECTION RD. A6
- SHARKEY RD. C3,C4,D3
- SHAWY RD. B5
- SHELEY RD. B4
- SHERMAN CREEK RD. A5
- SHOESTRING RD. C2,D2
- SHOOK RD. C6,C6
- SHORES DR. A6,A6
- SIMPSON DR. E4
- SMITH RD. C6,D6
- SNOW BRAKE RD. C2,C3
- SOUTH CREEK RD. B4,B6
- SOUTH RD. E4
- SPRINGHILL RD. B6
- STATEN RD. C3
- STEELE DR. B6
- STURDIVANT - WHITE ROCK RD. D2
- STURDIVANT RD. D2,D3
- SUNNER - MS 321 RD. C2,C3
- SWAN LAKE RD. C3,C3
- SYCAMORE FLAT RD. D6
- SYKES RD. C6
- TALLAHA RD. C5,C6,D6
- TANDY RD. C4
- TATE RD. B3
- TATUM POND RD. B6,C6
- TATUM POND RD.
- TAYLOR RD. D6
- TEASDALE RD. A5,A6,B6
- THIRD ST. E4
- THORNTON RD. B2
- THREE-WHEELER RD. A5
- TIPPO CREEK RD. C4
- TIPPO RD. C4,D4,E4
- TOM PAYNE RD. C6
- TOM RICE RD. B2
- TOOLE RD. A6
- TOWNES RD. E3
- TRIBBLE ROAD C6
- TUTWILER RD. B2,C2
- TWILIGHT DR. D2
- VANCE RD. B2,B3
- VALLEY RIDGE RD. B3
- WALDRUP RD. D2
- WARD LANE D6
- WEATHERALL DR. D6

Jerry Armstead Map

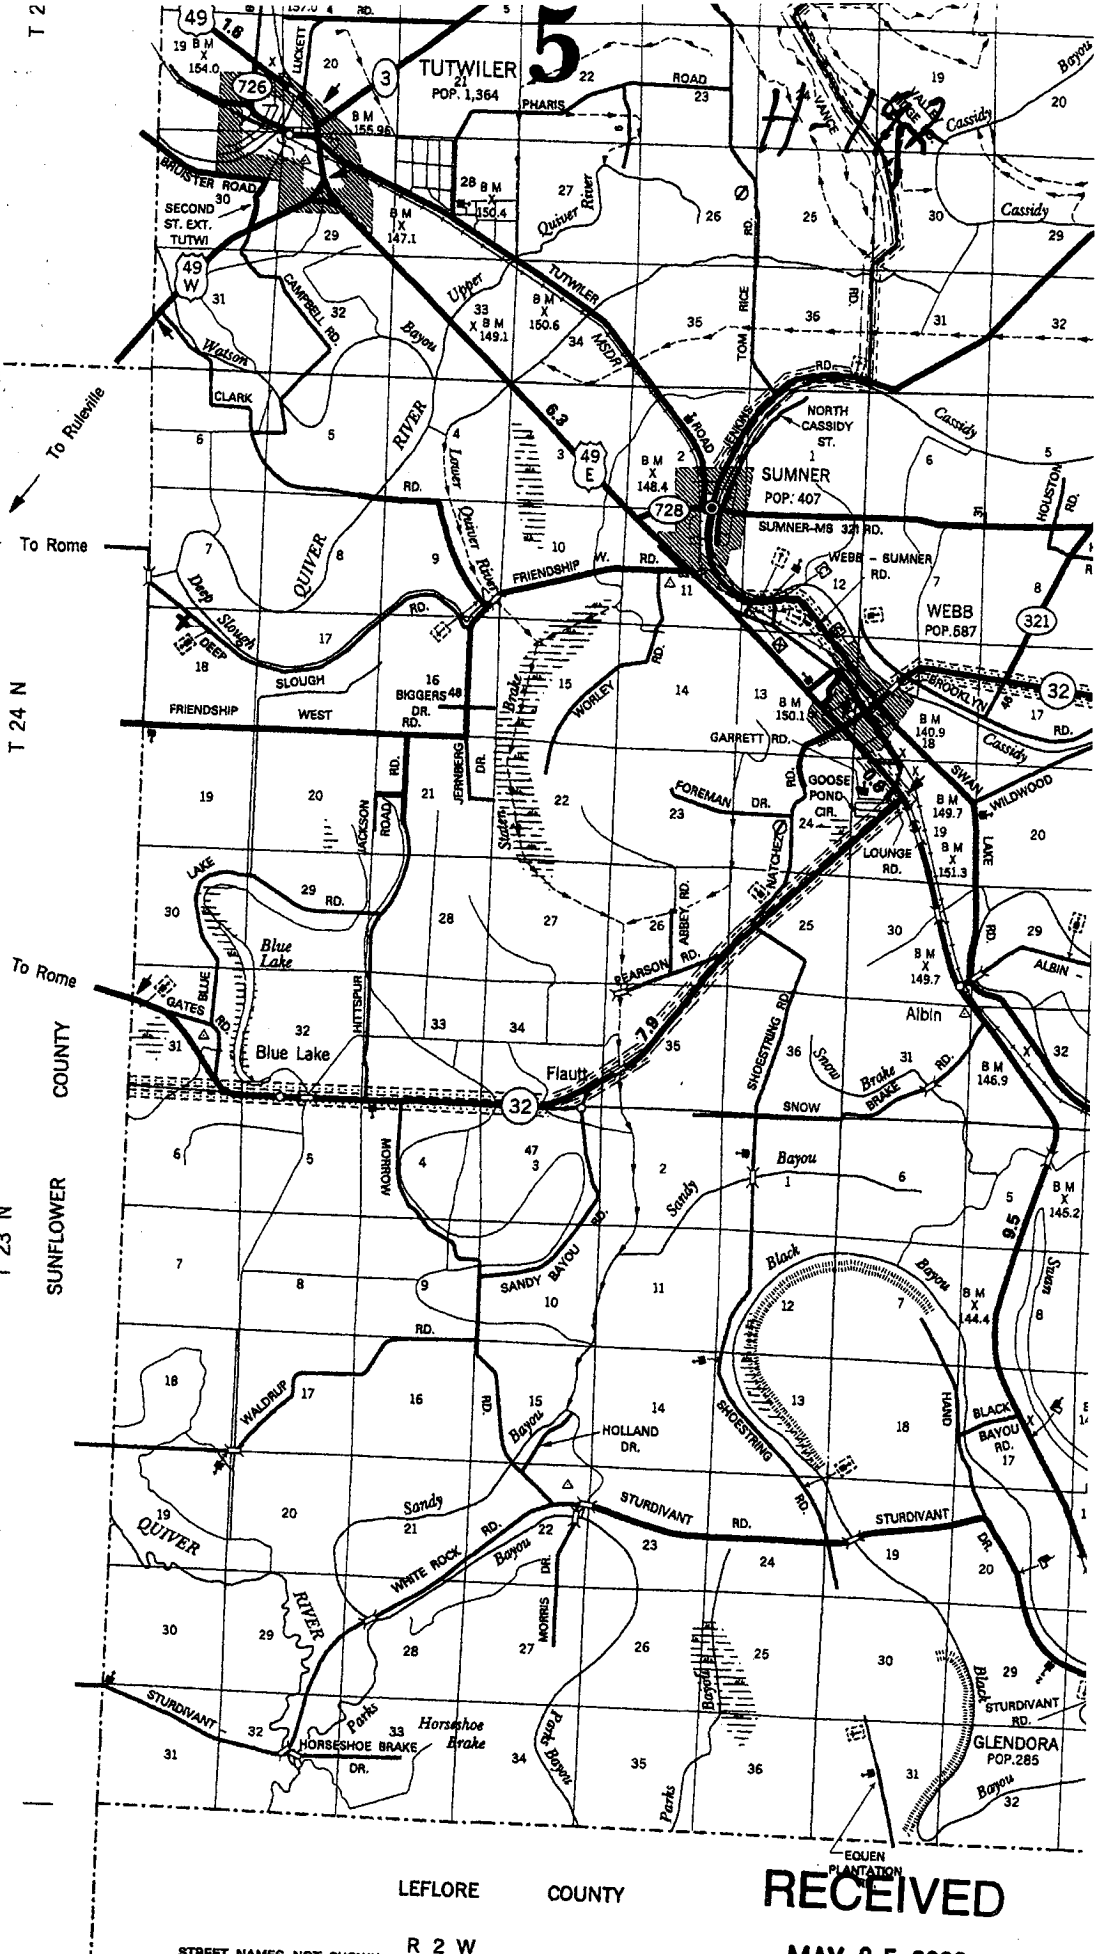

STREET NAMES NOT SHOWN

- 1. CORA LOVE DR. B2
- 2. WEATHERALL RD. B2
- 3. WILBOURNE DR. B2
- 4. LUCKETT DR. B2
- 5. TURNER RD. B2
- 6. PULLEN RD. B2

RECEIVED
MAY 05 2009
BY: OLWR