


H 2000

1-30-62

WATER WELL DRILLERS LOG

Date: JAN 30, 1962, Driller: DELTA DRILLING Co. County TALLAHATCHIE (Name)

	Description & Color of Materials Sand, Clay, Red Clay, Shell, etc.	Thick- ness Feet	Depth Feet
(1) Owner of Land: <u>E. A. ARMISTEAD</u> (Name)	GUMBO	21	21
<u>RTE. 3, TUTWILER, MISS.</u> (Address)	SAND	62	83
(2) Location: <u>SW 1/4, SW 1/4, Sec. 1 T24R2W</u>	GRAVEL	62	144
_____ miles _____ of _____ (distance) (direction) (Nearest Town)	GUMBO	52	196
(3) Topography: _____ (Hilly) (Flat) (Level)	SAND	114	310
(4) Purpose of Well: <u>DOMESTIC</u> (Domestic Irrigation Municipal, Industrial, Other)	GUMBO	90	400
Information upon completion of well:	SAND	67	467
(1) Diameter <u>3</u> inches.	GUMBO	19	486
(2) Total Depth <u>950</u> feet.	SHALE	59	545
(3) Water Level _____ feet below top of ground.	SAND	22	567
(4) Cased to <u>950</u> , Size <u>3+2"</u>	GUMBO	18	585
(5) Screen: Size <u>2"</u> , Length <u>20'</u>	GREEN SAND w/6" ROCK	43	628
(6) Were any formations sealed against pollution? _____ yes, _____ no.	GUMBO	42	670
If YES depth of formation _____	SHALE w/3" ROCK.	22	692
Why _____	SAND	20	712
Drillers Remarks: _____	SHALE	63	775
_____	SAND	175	950

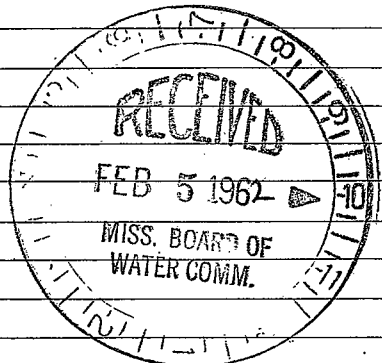

(Use Back Side)

Well No.

74