

TALLA. MISSISSIPPI BOARD OF WATER COMMISSIONERS

H 2001

3-5-63

WATER WELL DRILLERS LOG

3/20/63
1501

Date: March 5, 1963, Driller: Layne-Central Company County Tallahatchie

(Name)

(1) Owner of Land: Casburn Farms
(Name)
Sumner, Mississippi
(Address)

(2) Location: 1/4, 1/4, Sec. 3 T24N R2W
1 miles north of Sumner
(distance) (direction) (Nearest Town)

(3) Topography: Flat
(Hilly) (Flat) (Level)

(4) Purpose of Well: domestic
(Domestic Irrigation
Municipal, Industrial, Other)

Information upon completion of well:

(1) Diameter 4x3 inches.

(2) Total Depth 944'-10" feet.

(3) Water Level 2' above ground feet below top of ground.

(4) Cased to 104'-9", Size 4"
806'-9" 3"

(5) Screen: Size 3", Length 30'-4"


(6) Were any formations sealed against pollution?
yes yes, no no.

If YES depth of formation Packer above the screen. Mechanical seal at bottom.

Why

Drillers Remarks:

Description & Color of Materials Sand, Clay, Red Clay, Shell, etc.	Thick- ness Feet	Depth Feet
Clay	11	11
Brown sand	16	27
Sand	21	48
Coarse sand	22	70
Coarse sand & pea gravel	42	112
Coarse sand & gravel	20	132
Blue clay	29	161
Sand	39	200
Sand strks. brown shale	21	221
Clay	49	270
Shale	12	282
Rock	1	283
Shale	22	305
Sandy shale	58	363
Sand	95	438
Shale	26	484
Rock	1	485
Shale	4	489
Rock	2	491
Hard shale	9	500
Sandy shale	60	560
Shale	21	581
Shale strks. small rocks	19	600
Shale	22	622
Hard shale	32	654
Shale	108	701
Sand	6	768
Shale	41	809
Shale strks. sand	14	822
Shale	19	842
Sand strks. shale	43	885
Sand	59	944

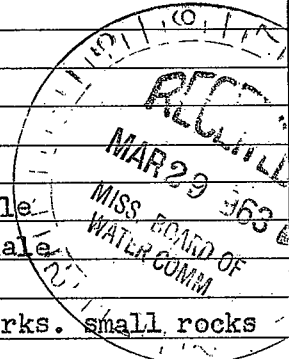

(Use Back Side)

Well No.

