

MISSISSIPPI DEPARTMENT OF NATURAL RESOURCES

Bureau of Land and Water Resources

Southport Mall

P.O. Box 10631

Jackson, Mississippi 39209

WATER WELL DRILLERS LOG

BUTANE GAS COMPANY

OF GREENWOOD

county well located

Zalabatchev
H
2002

9-2-82 1982
 date well completed

Zalabatchev
 county well located


LANDOWNER:	description of formations encountered	from	to
<u>Butch Vance</u>	<u>Clay</u>	<u>0</u>	<u>30</u>
<u>Webb Ms.</u> (mailing address)	<u>Sand</u>	<u>30</u>	<u>60</u>
	<u>Sand + gravel</u>	<u>60</u>	<u>105</u>
WELL LOCATION:			
sec. <u>22</u> T <u>24</u> N R <u>2</u> E			
(distance) (direction) (nearest town)			
<u>3 1/2</u> miles <u>SW</u> of <u>Sumner</u>			
WELL PURPOSE: <u>Domestic</u> (home, irrigation, municipal, industrial)			
WELL COMPLETION DATA:			
(1) diameter (inches) <u>4"</u>			
(2) total depth (feet) <u>105</u>			
(3) static water level (feet) <u>8</u> <u>below</u> top of ground.			
(4) casing <u>PVC</u> , <u>95</u> (material) (depth)			
<u>4"</u> if telescope see back. (size)			
(5) screen <u>20</u> , (length) (depth to top)			
<u>4"</u> , <u>PVC</u> (size) (material)			
(6) pump <u>3/4</u> , <u>20</u> (HP) (yield gpm)			
<u>Elect</u> (type power)			
(7) electric log <u>NO</u> (yes or no)			
<u>NO</u> (organization running log)			
(8) how well bottom plugged <u>Back well Valve</u>			
DRILLERS REMARKS:			
<u>Carlos RAMOS</u>			

DEPT. OF NATURAL RESOURCES
 BUREAU OF LAND & WATER RESOURCES

OCT 29 1982
RECEIVED

If well telescopes please sketch and show depths.

GROUND LEVEL

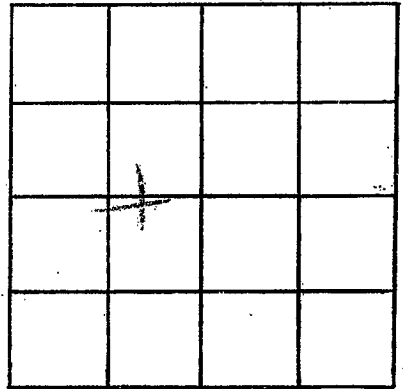

SECTION 92

Please indicate well location X.

ADDITIONAL INFORMATION

If more than one screen,
show locations of each on sketch.