

MISSISSIPPI DEPARTMENT OF NATURAL RESOURCES

Bureau of Land and Water Resources

Southport Mall

P.O. Box 10631

Jackson, Mississippi 39209

WATER WELL DRILLERS LOG

BUTANE GAS CO. OF GREENWOOD

POST OFFICE BOX 1135

GREENWOOD, MISS. 38930

Tallahatchie

county well located

Tallahatchie
H 1
H 2012

4-26 1982
 date well completed

LANDOWNER:	description of formations encountered	from	to
<u>Buena Plantation</u>			
<u>#1</u> (mailing address)	<u>sand</u>	<u>65</u>	<u>90</u>
WELL LOCATION:	<u>sand + gravel</u>	<u>90</u>	<u>105</u>
sec. <u>26</u> T <u>24</u> N R <u>2</u> E W <u>5</u>			
<u>5</u> miles <u>SW</u> of <u>Glendora</u>			
(distance) (direction) (nearest town)			
WELL PURPOSE: <u>irrigation</u>			
(home, irrigation, municipal, industrial)			
WELL COMPLETION DATA:			
(1) diameter (inches) <u>16"</u>			
(2) total depth (feet) <u>105</u>			
(3) static water level (feet) <u>15</u> <u>below</u> top of ground.			
(4) casing <u>Steel</u> , <u>65'</u> (material) (depth)			
<u>16"</u> (size) if telescope see back.			
(5) screen <u>40</u> , <u>65'</u> (length) (depth to top)			
<u>16</u> (size), <u>steel</u> (material)			
(6) pump _____ (HP) _____ (yield gpm)			
<u>Diesel</u> (type power)			
(7) electric log <u>NO</u> (yes or no)			
<u>NO</u> (organization running log)			
(8) how well bottom plugged <u>steel plate</u>			

DRILLERS REMARKS:

Carlos Ramos


DEPT. OF NATURAL RESOURCES
 BUREAU OF LAND & WATER RESOURCES

MAY 10 1982

RECEIVED

If well telescopes please sketch and show depths.

GROUND LEVEL

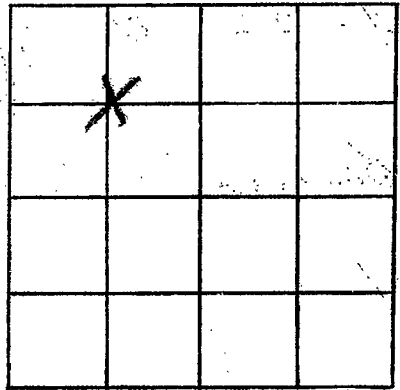

SECTION 25

Please indicate well location X.

ADDITIONAL INFORMATION

If more than one screen,
show locations of each on sketch.