

MISSISSIPPI DEPARTMENT OF NATURAL RESOURCES

Bureau of Land and Water Resources

Southport Mall

P.O. Box 10631

Jackson, Mississippi 39209

WATER WELL DRILLERS LOG

*Dull sketch*  
 H 2014

7

May 10 19 82  
 date well completed

BUTANE GAS CO. OF GREENWOOD

POST OFFICE BOX 1107

GREENWOOD, MISS. 39300

*Dull sketch*

LANDOWNER:  
*Morrow Farms*  
*Summer Mo.*  
 (mailing address)

description of formations encountered	from	to
<i>Clay</i>	<i>0</i>	<i>25</i>
<i>Gravel and gravel</i>	<i>25</i>	<i>95</i>

WELL LOCATION:  
 sec. *2* T. *24* N. R. *2* W.  
*1/2* miles *NW* of *Summer*  
 (distance) (direction) (nearest town)

WELL PURPOSE: *irrigation*  
 (home, irrigation, municipal, industrial)

- WELL COMPLETION DATA:
- (1) diameter (inches) 16"
  - (2) total depth (feet) 95
  - (3) static water level (feet) \_\_\_\_\_ below  
 top of ground. above
  - (4) casing steel, 55'  
 (material) (depth)
  - 16"  
 (size) if telescope see back.
  - (5) screen 40, 55'  
 (length) (depth to top)
  - 16"  
 (size) (material)
  - (6) pump 40, 600  
 (HP) (yield gpm)
  - Diaphragm  
 (type power)
  - (7) electric log NO  
 (yes or no)
  - NO  
 (organization running log)
  - (8) how well bottom plugged Steel plate

DRILLERS REMARKS:  
*Carlos Ramos*


DEPT. OF NATURAL RESOURCES  
 BUREAU OF LAND & WATER RESOURCES

JUN 17 1982

RECEIVED

If well telescopes please  
sketch and show depths.

GROUND LEVEL

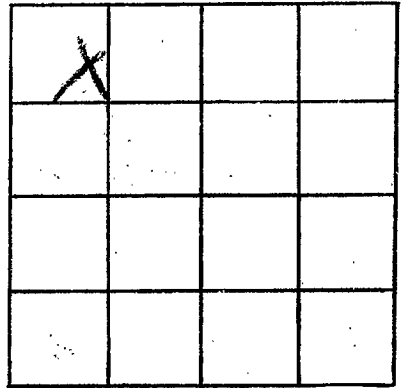

SECTION 2

Please indicate well location X.

ADDITIONAL INFORMATION

If more than one screen,  
show locations of each on sketch.