

TALLA. MISSISSIPPI BOARD OF WATER COMMISSIONERS

J-4
5-20-59

WATER WELL DRILLERS LOG

1/6/66
CODED

Date: May 20, 1959, Driller: Layne-Central Company County Tallahatchie

(Name)

- (1) Owner of Land: Meyer Turner
(Name)
Webb, Mississippi
(Address)
- (2) Location: SE 1/4, SE 1/4, Sec. 2 T4 R/W
5 miles northeast of Webb
(distance) (direction) (Nearest Town)
- (3) Topography: flat
(Hilly) (Flat) (Level)
- (4) Purpose of Well: domestic
(Domestic Irrigation
Municipal, Industrial, Other)

Description & Color of Materials Sand, Clay, Red Clay, Shell, etc.	Thick- ness Feet	Depth Feet
Clay	10	10
Fine brown sand	40	50
Coarse blue sand	20	70
Coarse sand & pea gravel	57	127
Shale	43	170
Shale, strks. of sand	100	270
Sand	45	315
Shale, strks. fine sand	48	363
Hard rock	1	364
Hard shale	4	368
Hard rock	1	369
Hard shale	16	385
Rock	1	386
Shale	134	520
Shale, strks. sand	85	645
Shale	4	729
Sandy shale	97	826
Sand	54	880

CODED

Information upon completion of well:


- (1) Diameter 4x3 inches.
- (2) Total Depth 880 feet.
- (3) Water Level flowing feet below top of ground.
71 1/2' 3"
- (4) Cased to 126', Size 4"
10" of 4x3 swage
- (5) Screen: Size 3", Length 31'
8' 7" of 3" blank
- (6) Were any formations sealed against pollution?
yes yes, no no.

If YES depth of formation. Packer above the screen and shot at bottom.

Why _____

Drillers Remarks: _____

20 GPM.

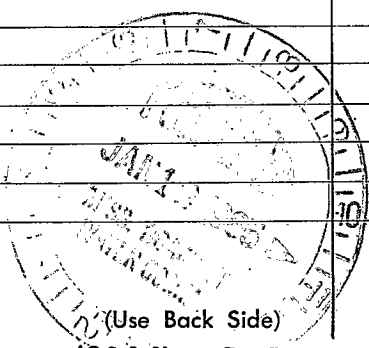

Well No.

