

J-5

11-30-64

WATER WELL DRILLERS LOG

CODED

Date: 11/30, 1964, Driller: Bailey Drilling Co County: Washington
 (Name)

- (1) Owner of Land: Hill & Co
 (Name)
Webb, Miss.
 (Address)
- (2) Location: 2627 E 29th St 33rd St T 29 R 1 W
1/4, 1/4, Sec. 1
- 4 miles S of Webb
 (distance) (direction) (Nearest Town)
- (3) Topography: Flat
 (Hilly) (Flat) (Level)
- (4) Purpose of Well: domestic
 (Domestic Irrigation
 Municipal, Industrial, Other)

Description & Color of Materials
 Sand, Clay, Red Clay, Shell, etc.

Thick-
ness
Feet

Depth
Feet

Clay	19
Sand	70
Gravel	115
Mud	170
Rocks + mud	241
Sand + mud	311
Mud	335
Sand	370

Information upon completion of well:


- (1) Diameter 4x3x2 1/2 inches.
- (2) Total Depth 370 feet.
- (3) Water Level 1 feet above top of ground.
- (4) Cased to all way, Size 4x3x2 1/2
- (5) Screen: Size 2 1/2, Length 30 ft
- (6) Were any formations sealed against pollution?
 _____ yes, X no.

CODED

If YES depth of formation _____

Why _____

Drillers Remarks: _____

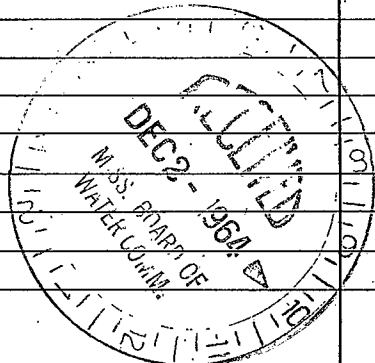

(Use Back Side)

Well No.

1950

1950

1950

1950