

~~11-12~~ 5-12
2-25-63

WATER WELL DRILLERS LOG

CODED

Date: 2-25-1963, Driller: Layne-Central Co. County Jackson
(Name)

CODED

- (1) Owner of Land: Joun of webb
(Name)
Webb, Mississippi
(Address)
- (2) Location: NE 1/4, SW 1/4, Sec. 18 24^N R1W
in Webb
(distance) (direction) (Nearest Town)
- (3) Topography: _____
(Hilly) (Flat) (Level)
- (4) Purpose of Well: municipal
(Domestic Irrigation
Municipal, Industrial, Other)


Description & Color of Materials. Sand, Clay, Red Clay, Shell, etc.	Thick- ness Feet	Depth Feet
clay	14	14
sand		70
sand-fine gravel		120
fine sand-fine "		203
sandy shale		218
hard shale		260
hard shale - sand sts.		325
sandy		342
dk. sand		407
hard shale - sts. sand		460
rock	1	461
shale	7	468
rock	6	474
shale - bedded		547
sandy shale - rock		615
fine sandy shale		673
sand	8	681
shale		700
sand	5	705
shale	96	801
sand shale sts.		828
shale		884
sandy shale		916

Information upon completion of well:

- (1) Diameter 16 inches.
- (2) Total Depth 833 feet.
- (3) Water Level 4' feet below top of ground.
- (4) Cased to 797', Size 10"
- (5) Screen: Size 6", Length 25'
- (6) Were any formations sealed against pollution?
X yes, _____ no.

If YES depth of formation 797'
Why Required

Drillers Remarks: _____

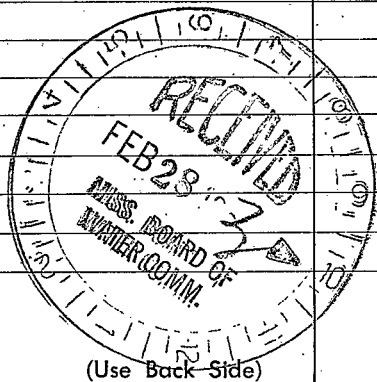

Well No.

1943

1943

1943