

TALLAHATCHIE
 36 J 13
 6-1-73

MISSISSIPPI
 BOARD OF WATER COMMISSIONERS
 416 North State Street
 Jackson, Mississippi 39201

CODED

WATER WELL DRILLERS LOG


1/1 /date well completed 1973 *Dallas Drilling* firm name Tallahatchie county well located

LANDOWNER:	description of formations encountered	from	to
<i>Houston Bros.</i>			
<i>Sumner Miss Rt.</i> (mailing address)	<i>Sand & Gravel</i>	18	90
WELL LOCATION: sec. <u>5</u> T <u>24</u> N R. <u>1</u> E <u>3</u> miles <u>East</u> of <u>Sumner</u> (distance) (direction) (nearest town)	<i>Sand & Gravel</i>	80	130
WELL PURPOSE: <i>Home</i> (home, irrigation, municipal, industrial)	<i>Clay & sand</i>	130	330
WELL COMPLETION DATA: (1) diameter (inches) <u>4 1/2</u>	<i>Sand</i>	330	365
(2) total depth (feet) <u>840</u>	<i>shale & clay</i>	365	580
(3) static water level (feet) <u>22</u> below top of ground.	CODED	580	581
(4) casing <u>Galv steel</u> (material) (depth)	<i>Sand</i>	581	585
(size) if telescope see back.	<i>Rock & shale</i>	585	730
(5) screen <u>20 ft</u> (length) (depth to top)	<i>Clay & sand</i>	730	800
<u>3"</u> <u>stainless steel</u> (size) (material)	<i>Sand</i>	800	840
(6) pump <u>1</u> <u>20</u> (HP) (yield gpm)			
<u>Elec</u> (type power)			
(7) electric log <u>no</u> (yes or no)			
(organization running log)			
(8) how well bottom plugged <u>B.P. Vaher</u>			
DRILLERS REMARKS:			

JUL 30 1973

If well telescopes please sketch and show depths.

GROUND LEVEL

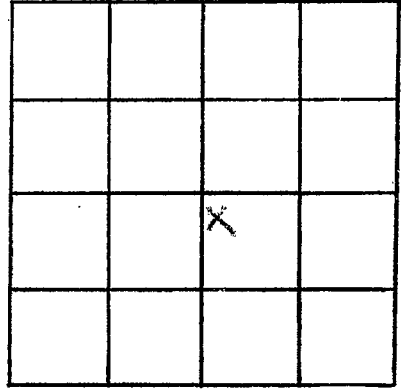

SECTION

Please indicate well location X.

ADDITIONAL INFORMATION

Lined area for additional information.

If more than one screen, show locations of each on sketch.