

Tallahatchie
J 18
1-9-75

MISSISSIPPI
BOARD OF WATER COMMISSIONERS **CODED**
 416 North State Street
 Jackson, Mississippi 39201
WATER WELL DRILLERS LOG

200

1-9-75 19 1975 **BUTANE GAS CO. OF GREENWOOD** Tallahatchie
 date well completed firm name county well located

LANDOWNER:
Rain Bow Plantation
Webb
 (mailing address)

description of formations encountered	from	to
<u>Clay</u>	<u>0</u>	<u>20</u>
<u>Fine Sand</u>	<u>20</u>	<u>50</u>
<u>COARSE Sand</u>	<u>50</u>	<u>60</u>
<u>Sand & Gravel</u>	<u>60</u>	<u>100</u>

WELL LOCATION:
 sec. 8 T. 24 N. R. 1 E
 S W
2 miles NE of Webb
 (distance) (direction) (nearest town)

WELL PURPOSE: IRR
 (home, irrigation, municipal, industrial)

WELL COMPLETION DATA:

(1) diameter (inches) 6"

(2) total depth (feet) 100'

(3) static water level (feet) 16' below above top of ground.

(4) casing Steel, 60'
 (material) (depth)
6" If telescope see back.
 (size)

(5) screen 40', 60'
 (length) (depth to top)
6", Steel
 (size) (material)

(6) pump 40, 1000
 (HP) (yield gpm)
Diesel Tractor
 (type power)

(7) electric log No
 (yes or no)

(organization running log)

(8) how well bottom plugged Steel plate

CODED

RECEIVED
JAN 21 1975


DRILLERS REMARKS:

MISC. DR.

IM

If well telescopes please sketch and show depths.

GROUND LEVEL

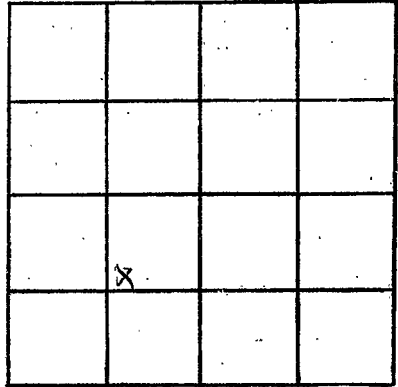

SECTION 8

Please indicate well location X.

ADDITIONAL INFORMATION

Lined area for additional information, consisting of approximately 20 horizontal lines.

If more than one screen, show locations of each on sketch.