

Tallahatchie

J 22

3/6/78

MISSISSIPPI BOARD OF WATER COMMISSIONERS  
416 North State Street  
Jackson, Mississippi 39201

CODED

WATER WELL DRILLERS LOG  
BUTANE GAS COMPANY

3/6/78

date well completed

19

OF GREENWOOD

Tallahatchie  
county well located

LANDOWNER:	description of formations encountered	from	to
RAI PH. HAND Glendora (mailing address)	Clay Fine Sand COARSE SAND SAND & GRAVEL	0 10 30 40	10 30 40 103
WELL LOCATION: sec. 32 T. 24 N R. 1 W 1/2 miles NW of Swadlake (distance) (direction) (nearest town)			
WELL PURPOSE: FKR (home, irrigation, municipal, industrial)			
WELL COMPLETION DATA: (1) diameter (inches) 12 (2) total depth (feet) 103 (3) static water level (feet) 18 below above top of ground. (4) casing Steel 63 (material) (depth) 12 (size) if telescope see back. (5) screen 40 63 (length) (depth to top) 12 (size) Steel (material) (6) pump 30 1200 (HP) (yield gpm) Diesel (type power) (7) electric log NO (yes or no) (organization running log) (8) how well bottom plugged Steel Plate			
DRILLERS REMARKS:			


RECEIVED

MAR 23 1978

MISS. Bd. OF WATER COMM.

If well telescopes please sketch and show depths.

GROUND LEVEL

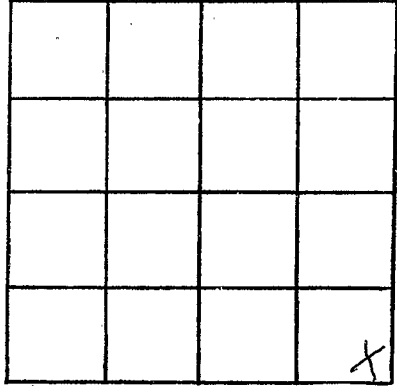

SECTION 32

Please indicate well location X.

ADDITIONAL INFORMATION

Lined area for additional information.

If more than one screen, show locations of each on sketch.