

TALLAHATCHIE
J 23
7/6/78

MISSISSIPPI
BOARD OF WATER COMMISSIONERS
416 North State Street
Jackson, Mississippi 39201

WATER WELL DRILLERS LOG
BUTANE GAS COMPANY

CODED

Tallahatchie
county well located

7-6-78
date well completed

OF GREENWOOD
name

LANDOWNER:
Rainbow Plantation
Webb
(mailing address)

description of formations encountered	from	to
Clay	0	15
Sand	15	50
SAND + GRAVEL	50	102

WELL LOCATION:
sec. 17 T. 24 N. R. 1 E
S W
1 miles E of Webb
(distance) (direction) (nearest town)

WELL PURPOSE: IRR
(home, irrigation, municipal, industrial)

WELL COMPLETION DATA:
(1) diameter (inches) 6"
(2) total depth (feet) 102
(3) static water level (feet) 20 below top of ground.
(4) casing Steel, 62 (material) (depth)
6" (size) if telescope see back.
(5) screen 40' (length), 62 (depth to top)
6" (size), steel (material)
(6) pump 40 (HP), 1000 (yield gpm)
LP GAS (type power)
(7) electric log NO (yes or no)
(organization running log)
(8) how well bottom plugged
Steel Plate

CODED

RECEIVED


JUL 6 7 1978

DRILLERS REMARKS:

MISS. BD. OF WATER COMM

If well telescopes please sketch and show depths.

GROUND LEVEL

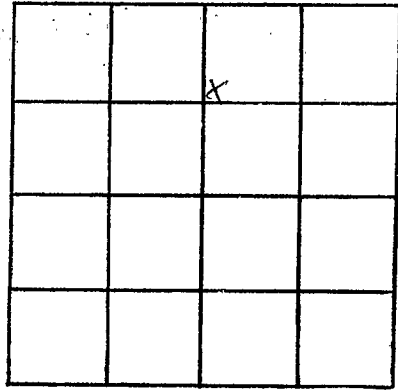

SECTION 17

Please indicate well location X.

ADDITIONAL INFORMATION

If more than one screen, show locations of each on sketch.