

TALLAHATCHIE
 T 24
 7-26-78

MISSISSIPPI
 BOARD OF WATER COMMISSIONERS
 416 North State Street
 Jackson, Mississippi 39201

CODED

WATER WELL DRILLERS LOG

7-26 1978 ^{ASSN} Five Cr FARMERS Tallahatchie
 date well completed firm name county well located

LANDOWNER: <u>W. B. DONAVANT</u>	description of formations encountered	from	to
<u>DELTA HAVEN PLANTATION</u> (mailing address)	<u>top sand</u>	0	12
	<u>fine sand</u>	12	22
	<u>Coarse sand</u>	22	46
	<u>sand & pebbles</u>	46	64
	<u>sand & gravel</u>	64	112

LANDOWNER: W. B. DONAVANT

description of formations encountered

from to

DELTA HAVEN PLANTATION

top sand

0 12

(mailing address)

fine sand

12 22

WELL LOCATION:

Coarse sand

22 46

sec. 3 T 24 (N) R 1 E
 S W

sand & pebbles

46 64

4 miles SOUTH of BRAZIL
 (distance) (direction) (nearest town)

sand & gravel

64 112

WELL PURPOSE: irrigation
 (home, irrigation, municipal, industrial)

CODED

WELL COMPLETION DATA:

(1) diameter (inches) 16"

(2) total depth (feet) 112

(3) static water level (feet) 13 below top of ground. above

(4) casing steel, 60
 (material) (depth)

16" if telescope see back.
 (size)

(5) screen 52', 60'
 (length) (depth to top)

16", dash 50 slot
 (size) (material)

(6) pump 60 3000
 (HP) (yield gpm)

diesel
 (type power)

(7) electric log NO
 (yes or no)

(organization running log)

(8) how well bottom plugged washed

RECEIVED


AUG 18 1978

DRILLERS REMARKS:

MISS. BD. OF WATER COMM

If well telescopes please sketch and show depths.

GROUND LEVEL

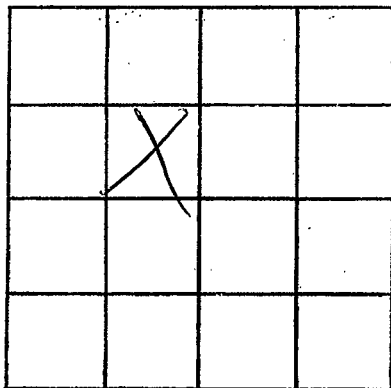

SECTION _____

Please indicate well location X.

ADDITIONAL INFORMATION

If more than one screen, show locations of each on sketch.