

TALLAHATCHIE
 J25
 3-20-79
 Flu #52

MISSISSIPPI
 BOARD OF WATER COMMISSIONERS
 416 North State Street
 Jackson, Mississippi 39201

CODED

WATER WELL DRILLERS LOG

2-20-1979 date well completed
 Fico Farms, Inc. firm name
 Tallahatchie county well located

LANDOWNER: TOM JONES
DELTA HAVEN PLANTATION
Webb, Miss.
 (mailing address)

WELL LOCATION:
 sec. 14 T24 N R 1 E
S miles East of Webb
 (distance) (direction) (nearest town)

WELL PURPOSE: Home
 (home, irrigation, municipal, industrial)

- WELL COMPLETION DATA:
- (1) diameter (inches) 4x7
 - (2) total depth (feet) 723
 - (3) static water level (feet) 18" ^{below} _{above} top of ground.
 - (4) casing Galv. steel 703
 (material) (depth)
4x7 If telescope see back.
 (size)
 - (5) screen 20' 703
 (length) (depth to top)
2 1/2" stainless steel
 (size) (material)
 - (6) pump 1 25
 (HP) (yield gpm)
Electric
 (type power)
 - (7) electric log Yes
 (yes or no)
U.S.G.S. M55S
 (organization running log)
 - (8) how well bottom plugged Back wash

description of formations encountered	from	to
top clay	0	10
fine sand	10	52
sand & silt	52	118
clay	118	155
med sand	155	220
rock	220	235
fine sand	235	250
clay	250	290
blue mud	290	580
fine sand	580	610
rock	610	615
clay	615	640
rock	640	646
blue mud	646	700
white sand	700	723
bluish clay	723	60

CODED

Miss. Board of Water Comm.


MAR 27 1979

RECEIVED

DRILLERS REMARKS:

If well telescopes please sketch and show depths.

GROUND LEVEL

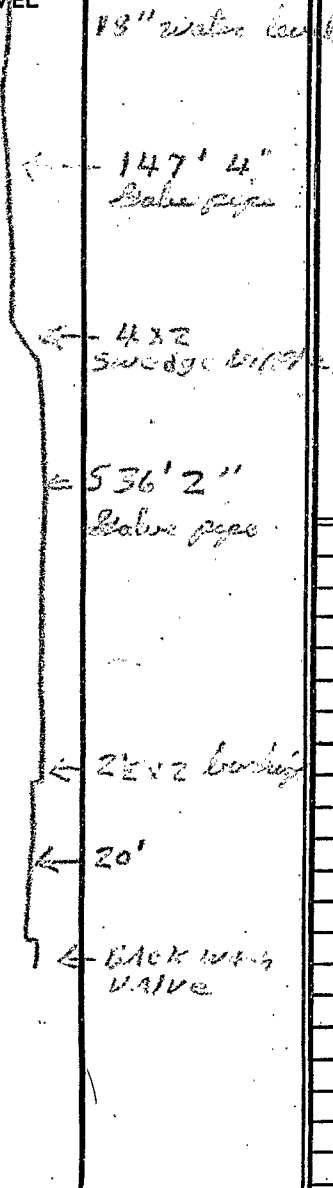

	X		

SECTION 14

Please indicate well location X.

ADDITIONAL INFORMATION

If more than one screen, show locations of each on sketch.