

**MISSISSIPPI
BOARD OF WATER COMMISSIONERS**
416 North State Street
Jackson, Mississippi 39201

CODED

WATER WELL DRILLERS LOG

Tallahatchie
J 27
CT-1510
5/4/80

54-1980 date well completed Layne-Central Co. firm name Tallahatchie county well located

LANDOWNER:
J. H. Morrow
Webb, MS
(mailing address)

description of formations encountered	from	to
Clay	0	40
Coarse sand	40	50
Coarse sand & Gra.	50	107
Clay	107	

WELL LOCATION:
3 sec. 9 T 25 N 24 W R 1 E
4 miles NE of Webb
(distance) (direction) (nearest town)

WELL PURPOSE: Irrigation
(home, irrigation, municipal, industrial)

WELL COMPLETION DATA:

(1) diameter (inches) 32"

(2) total depth (feet) 107'

(3) static water level (feet) 19 below above top of ground.

(4) casing Steel, 67'
(material) (depth)
16" if telescope see back.
(size)

(5) screen 40', 67'
(length) (depth to top)
16", St. Steel
(size) (material)

(6) pump 60 2800
(HP) (yield gpm)
diesel
(type power)

(7) electric log no
(yes or no)
(organization running log)

(8) how well bottom plugged st. plate


DRILLERS REMARKS:

DEPT. OF NATURAL RESOURCES
BUREAU OF LAND & WATER RESOURCES

FEB 19 1980
RECEIVED

If well telescopes please sketch and show depths.

GROUND LEVEL

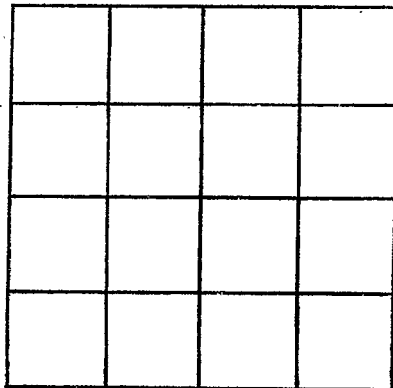

SECTION _____

Please indicate well location X.

ADDITIONAL INFORMATION

If more than one screen,
show locations of each on sketch.