

MISSISSIPPI DEPARTMENT OF NATURAL RESOURCES

Bureau of Land and Water Resources

Southport Mall

P.O. Box 10631

CODED

Jackson, Mississippi 39209

WATER WELL DRILLERS LOG

Tallahatchie
J29
6-3-81

6-3 1981 BUTANE GAS COMPANY Tallahatchie
date well completed OF GREENWOOD county well located

LANDOWNER:	description of formations encountered	from	to
Paul Melton Farms			
Webb Ms. (mailing address)	SAND	20	75
	Gravel	75	125
WELL LOCATION: sec. 31 T 24 N R 1 W 3 miles S of Webb (distance) (direction) (nearest town)	Clay	125	135
	Sand	135	330
	Sand & Clay	330	415
	Sand	415	440
	Clay	440	510
	Shale + Rock	510	660
	Sand + shale	660	740
	Clay with sand s.	740	935
WELL PURPOSE: Domestic (home, irrigation, municipal, industrial)	Sand	935	980

WELL COMPLETION DATA:

(1) diameter (inches) 4" x 3"

(2) total depth (feet) 975

(3) static water level (feet) 30 below top of ground.

(4) casing Steel, 945 (material) (depth)
4" x 3" if telescope see back. (size)

(5) screen 30 (length) (depth to top)
3" Stainless Steel (size) (material)

(6) pump 3 (HP) 40 (yield gpm)
Electric (type power)

(7) electric log (yes or no)

(organization running log)

(8) how well bottom plugged back wash Valve

CODED

DEPT. OF NATURAL RESOURCES
BUREAU OF LAND & WATER RESOURCES


JUN 15 1981

RECEIVED

DRILLERS REMARKS:

If well telescopes please
sketch and show depths.

GROUND LEVEL

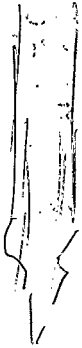

X			

SECTION 31

Please indicate well location X.

ADDITIONAL INFORMATION

If more than one screen,
show locations of each on sketch.