

Tallahatchie
 T30
 4-10-81


MISSISSIPPI
 BOARD OF WATER COMMISSIONERS
 416 North State Street
 Jackson, Mississippi 39201

CODED

WATER WELL DRILLERS LOG


April 10 19 81 Bruce Berryman - TALLAHATCHIE
 date well completed firm name county well located
 Greenwood.

LANDOWNER: Mr. Tom Jones	description of formations encountered		from	to
Delta Haven Plantation, Box 607, Webb. MS 38966 (mailing address)	Clay		0	20
	Sand		20	80
	Sand & Gravel		80	140
	Clay		140	220
	Sand		220	260
	Clay		260	320
	Hard rock & shale		320	360
	Sandy shale		360	400
	Shale & sand		400	460
	Shale		460	470
WELL LOCATION: sec. 14 T. 24 (N) S. R. 1 E. (W) 5 miles E of Webb. (distance) (direction) (nearest town)	Sand		470	480
WELL PURPOSE: Home (home, irrigation, municipal, industrial)	Shale		480	540
WELL COMPLETION DATA:	Brown sand		540	560
(1) diameter (inches) 4" x 2"	Sandy shale		560	590
(2) total depth (feet) 760 ft.	Sand		590	600
(3) static water level (feet) 6' below top of ground.	Shale		600	640
(4) casing 2" blk. galv. - 126' (material) (depth)	Sandy shale		640	710
_____ If telescope see back. (size)	Sand		710	770
(5) screen 20' length, 742' depth to top .010, Stainless steel (size) (material)				
(6) pump 2 p.p. 40 (HP) (yield gpm) Electric (type power)				
(7) electric log No (yes or no) (organization running log)				
(8) how well bottom plugged B.P.V.				
DRILLERS REMARKS:				

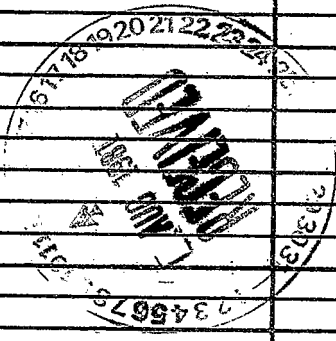

If well telescopes please sketch and show depths.

GROUND LEVEL

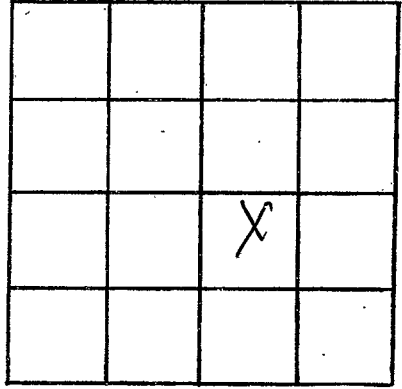

SECTION 14

Please indicate well location X.

ADDITIONAL INFORMATION

If more than one screen,
show locations of each on sketch.