

MISSISSIPPI DEPARTMENT OF NATURAL RESOURCES

Bureau of Land and Water Resources

Southport Mall

P.O. Box 10631

Jackson, Mississippi 39209

WATER WELL DRILLERS LOG

CODED

TALLAHATCHIE
537
12/3/83

12/3/83

date well completed

J+K Irrigation

firm name

Tallahatchie

county well located

LANDOWNER: Leo Hill
WEBB Missouri
(mailing address)

description of formations encountered

from

to

CLAY	0	14
FINE SAND	14	24
SAND gravel	24	100

WELL LOCATION:

sec. 29 T. 24 N. R. 1 E. S. 5
2 1/2 miles NE of WEBB
(distance) (direction) (nearest town)

WELL PURPOSE:

(home, irrigation, municipal, industrial)

WELL COMPLETION DATA:

- (1) diameter (inches) 12"
- (2) total depth (feet) 100
- (3) static water level (feet) 12 below above top of ground.
- (4) casing steel 60 (material) (depth)
- 12 (size) if telescope see back.
- (5) screen 40 60 (length) (depth to top)
- 12" steel (size) (material)
- (6) pump 60 1200 (HP) (yield gpm)
- diesel (type power)
- (7) electric log no (yes or no)

CODED

(organization running log)

(8) how well bottom plugged plate

DEPT. OF NATURAL RESOURCES
BUREAU OF LAND & WATER RESOURCES


DEC 29 1983

DRILLERS REMARKS:

RECEIVED

If well telescopes please sketch and show depths.

GROUND LEVEL

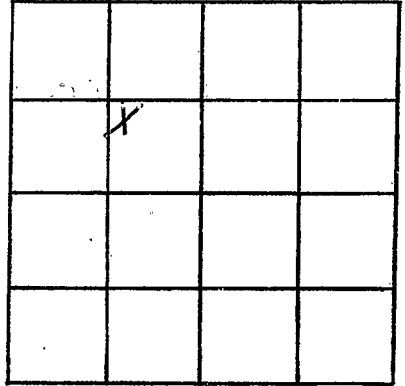

SECTION 29

Please indicate well location X.

ADDITIONAL INFORMATION

If more than one screen,
show locations of each on sketch.