

MISSISSIPPI DEPARTMENT OF NATURAL RESOURCES

Bureau of Land and Water Resources

Southport Mall

P.O. Box 10631

CODED

Jackson, Mississippi 39209

WATER WELL DRILLERS LOG

TALLAHATCHIE  
J 38

March 10, 1984 date well completed      Dyer Well + Irrigation firm name      Tallahatchie county well located

LANDOWNER: <u>William Falls</u>	description of formations encountered	from	to
<u>Webb, Miss.</u> (mailing address)	<u>Clay</u>	<u>0</u>	<u>28</u>
	<u>fine sand</u>	<u>28</u>	<u>38</u>
	<u>sand</u>	<u>38</u>	<u>48</u>
	<u>sand &amp; gravel</u>	<u>48</u>	<u>96</u>
WELL LOCATION: sec. <u>31 T 24 N</u> R. <u>1 E</u> <u>S</u> (W) <u>2</u> miles <u>South</u> of <u>Webb</u> (distance) (direction) (nearest town)			<u>rock</u>
WELL PURPOSE: <u>Irrigation</u> (home, irrigation, municipal, industrial)	CODED		
WELL COMPLETION DATA:			
(1) diameter (inches) <u>1 1/2"</u>			
(2) total depth (feet) <u>96'</u>			
(3) static water level (feet) <u>25'</u> below above top of ground.			
(4) casing <u>Steel</u> , <u>5 1/2'</u> (material) (depth)			
<u>1 1/2"</u> if telescope see back. (size)			
(5) screen <u>40'</u> , <u>5 1/2'</u> (length) (depth to top)			
<u>1 1/2"</u> , <u>Mild Steel</u> (size) (material)			
(6) pump <u>1 1/2 HP</u> , <u>1 100</u> (HP) (yield gpm)			
<u>Diesel</u> (type power)			
(7) electric log <u>No</u> (yes or no)			
(organization running log)			
(8) how well bottom plugged <u>Plate</u>			
DRILLERS REMARKS:			


DEPT. OF NATURAL RESOURCES  
BUREAU OF LAND & WATER RESOURCES

JUL - 2 1984

RECEIVED

If well telescopes please  
sketch and show depths.

GROUND LEVEL

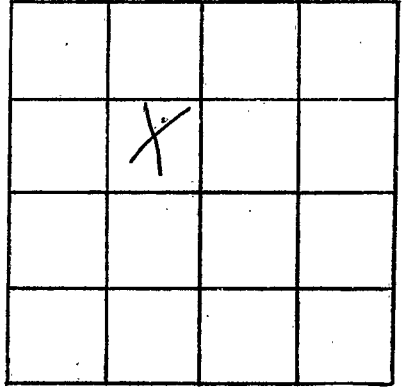

SECTION 31

Please indicate well location X.

ADDITIONAL INFORMATION

If more than one screen,  
show locations of each on sketch.