

MISSISSIPPI DEPARTMENT OF NATURAL RESOURCES

Bureau of Land and Water Resources

Southport Mall

P.O. Box 10631

Jackson, Mississippi 39209

WATER WELL DRILLERS LOG

CODED

J39
TALLAHATCHIE
8-15-1984

19 Powerell IRR TALLAHATCHIE
date well completed firm name county well located

LANDOWNER:
Smith Murphy
Webb, MS
(mailing address)

description of formations encountered	from	to
CLAY	0	23
FINE SAND	23	50
MED GRAY SAND	50	70
CHANCE SAND	70	126
POA GRAVEL		

WELL LOCATION:
sec. 20 T 24 N R 1 E
S W
3 miles S.E. of Webb
(distance) (direction) (nearest town)

WELL PURPOSE: IRR
(home, irrigation, municipal, industrial)

- WELL COMPLETION DATA:
- (1) diameter (inches) 16
 - (2) total depth (feet) 126
 - (3) static water level (feet) 23 below above top of ground.
 - (4) casing Steel, 76 below above top of ground.
(material) (depth)
 - (size) if telescope see back.
 - (5) screen 46, 86 below above top of ground.
(length) (depth to top)
 - 16, Steel
(size) (material)
 - (6) pump 30, 2000 below above top of ground.
(HP) (yield gpm)
 - Diesel
(type power)
 - (7) electric log NO
(yes or no)

(organization running log)

(8) how well bottom plugged
Steel Plate

DRILLERS REMARKS:


DEPT. OF NATURAL RESOURCES
BUREAU OF LAND & WATER RESOURCES

NOV 29 1984

RECEIVED

If well telescopes please sketch and show depths.

GROUND LEVEL

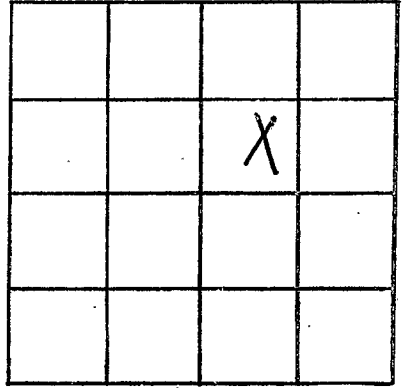

SECTION

20

Please indicate well location X.

ADDITIONAL INFORMATION

If more than one screen,
show locations of each on sketch.