

MISSISSIPPI DEPARTMENT OF NATURAL RESOURCES

Bureau of Land and Water Resources

Southport Mall

P.O. Box 10631

Jackson, Mississippi 39209

WATER WELL DRILLERS LOG

CODED

Tallahatchie  
JMO

4 1986  
date well completed

86 Powell Inc  
firm name

Tallahatchie  
county well located


LANDOWNER:	description of formations encountered	from	to
J. E. SHAW, ESTATE Webb MS 38966 (mailing address)			
WELL LOCATION: sec <u>22</u> T <u>24</u> N R <u>1</u> W <u>5</u> miles <u>E</u> of <u>Webb</u> (distance) (direction) (nearest town)			
WELL PURPOSE: <u>IRRIGATION</u> (home, irrigation, municipal, industrial)			
WELL COMPLETION DATA:			
(1) diameter (inches) <u>16"</u>			
(2) total depth (feet) <u>110</u>			
(3) static water level (feet) <u>21</u> below top of ground.			
(4) casing <u>16</u> <sup>Steel</sup> <u>80</u> (material) (depth)			
_____ If telescope see back. (size)			
(5) screen <u>30</u> <u>80</u> (length) (depth to top)			
<u>16</u> <u>Steel</u> (size) (material)			
(6) pump <u>30</u> <u>1500</u> (HP) (yield gpm)			
<u>diesel</u> (type power)			
(7) electric log <u>NO</u> (yes or no)			
_____ (organization running log)			
(8) how well bottom plugged <u>Steel</u> <u>PLATE</u>			
DRILLERS REMARKS: <u>86092CUG-01</u>			

RECEIVED  
APR 9 1986

Department of Natural Resources  
Bureau of Land and Water Resources

If well telescopes please sketch and show depths.

GROUND LEVEL

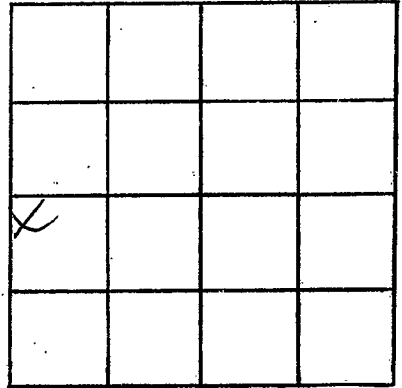

SECTION 22

Please indicate well location X.

ADDITIONAL INFORMATION

If more than one screen, show locations of each on sketch.