

MISSISSIPPI DEPARTMENT OF NATURAL RESOURCES

Bureau of Land and Water Resources

10813  
 COUNTY WELL LOCATED  
*Tallahatchie*  
 WELL NUMBER  
 358  
 CODED  
 PERMIT NUMBER  
 NAME OF DRILLING FIRM  
**Butane Gas Co.**  
 DATE WELL COMPLETED  
 5-19-89

PERMIT NUMBER  
 CODED  
 NAME OF DRILLING FIRM  
**Butane Gas Co.**

P.O. Box 10631  
 Jackson, Mississippi 39209  
 WATER WELL DRILLERS LOG

NAME & MAILING ADDRESS OF LANDOWNER  
*Sturdivant Farms*  
*P.O. Box 230*  
*Blendon, Mo 38946*  
 WELL LOCATION: SEC TOWNSHIP RANGE  
 7 24<sup>N</sup> 1<sup>E</sup>  
 DISTANCE DIRECTION NEAREST TOWN  
 2 Miles E of *Summer*  
 OTHER LANDMARK  
*Irish Forest*  
 WELL PURPOSE: Home, Irrigation, Municipal, Industrial, Fish Pond, etc.  
*Irish Forest*

PUMP DATA  
 PUMP TYPE (Circle One):  
 Submersible, Turbine, Jet, Flowing Well,  
 Other (Describe) \_\_\_\_\_  
 POWER TYPE (Circle One):  
 Electric, Tractor, Diesel, Gasoline, Butane,  
 Other (Describe) \_\_\_\_\_ H/P 60  
 Pump Capacity (GPM) No. of Stages Setting Depth  
 700 3 60 FT.  
 PUMP TEST  
 Well yielded 700 GPM with  
 a drawdown of 9 ft.  
 after 2 hours of pumping

WELL DATA  
 Well Depth Casing Diameter (In.) Casing Length (Ft.)  
 100 12" 60  
 Type of Casing Hole Depth Depth to Static Water Level  
 Steel 100 16  
 TYPE OF COMPLETION: (Circle One or More):  
Gravel Packed, Underreamed, Telescoped,  
 Natural Development, Open Hole, Other  
 (Describe) \_\_\_\_\_  
 Top of Lap Pipe or Reduction in Casing  
 FEET IF TELESCOPED OR MORE THAN ONE SCREEN: USE BACK PAGE

LOG DATA  
 TYPE OF LOG RUN (Circle One): No Log Run,  
 Electric, Gamma Ray, Density, Sonic, Neutron,  
 Other (Describe) \_\_\_\_\_  
 Name of Organization Running Log

SCREEN DATA  
 Diameter - Inches Length - Feet Slot Size - Inches  
 12" 40' 30T  
 Screen Type Depth to Bottom - Feet  
 Wire wrap 100

GEOLOGIC DATA (Office Use Only)  

Surface Elev.	Geologic Unit	Unit Thickness	Depth to Top
Subs. SWL	Date	Analysis	Aquifer Test


 Driller's Remarks

DESCRIPTION OF FORMATIONS ENCOUNTERED	FROM	TO	FORMATIONS (Continued)	FROM	TO
<i>Topsoil</i>	1	13	<b>RECEIVED</b>		
<i>Clay</i>	13	27			
<i>fine sand &amp; silt</i>	27	39			
<i>fine sand</i>	39	51			
<i>coarse sand</i>	51	88			
<i>coarse sand &amp; gravel</i>	88	100			
			JUN 19 1989		
			Department of Natural Resources Bureau of Land & Water Resources		

IF MORE SPACE IS NEEDED, USE BACK

If well telescopes please sketch and show depths.

GROUND LEVEL

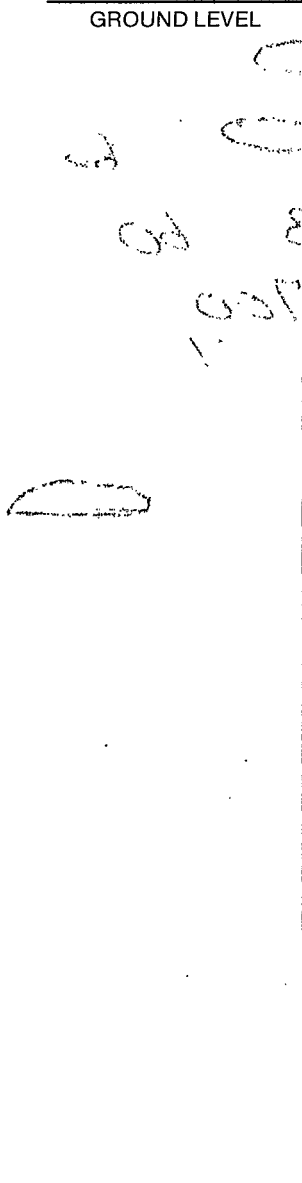


SECTION

Please indicate well location X.

ADDITIONAL INFORMATION

Handwritten notes and sketches in the 'ADDITIONAL INFORMATION' section. The notes are written on horizontal lines and include various numbers and descriptions. There are also some small hand-drawn ovals and lines interspersed with the text.

If more than one screen, show location of each on sketch.