

MISSISSIPPI DEPARTMENT OF NATURAL RESOURCES
 Bureau of Land and Water Resources
 Southport Mall
 P.O. Box 10631
 Jackson, Mississippi 39209
WATER WELL DRILLERS LOG

CODED

Tallahatchie
J 87
7/20/84

7-20
 date well completed

19 84 **BUTANE GAS COMPANY**
OF GREENWOOD

Tallahatchie
 county well located

LANDOWNER:
Rainbow Pkt.
 (mailing address)

description of formations encountered	from	to
<u>Clay</u>	<u>0</u>	<u>6</u>
<u>Fine sand</u>	<u>6</u>	<u>65</u>
<u>Some gravel</u>	<u>65</u>	<u>103</u>

WELL LOCATION:
 sec. 18 T 24 N R 1 E
S W
1.5 miles NE of Webb
 (distance) (direction) (nearest town)

WELL PURPOSE:
 (home, irrigation, municipal, industrial)

- WELL COMPLETION DATA:**
- (1) diameter (inches) 8"
 - (2) total depth (feet) 103'
 - (3) static water level (feet) 30 ^{below} above top of ground.
 - (4) casing Steel (material), 63' (depth)
8" (size) if telescope see back.
 - (5) screen 40' (length), 63' (depth to top)
8" (size), steel (material)
 - (6) pump 10 (HP), 500 (yield gpm)
Elec. (type power)
 - (7) electric log No (yes or no)
No (organization running log)
 - (8) how well bottom plugged steel plate

CODED

DEPT. OF NATURAL RESOURCES
 BUREAU OF LAND & WATER RESOURCES


AUG 6 1984

RECEIVED

DRILLERS REMARKS:
R. L. [Signature]

If well telescopes please sketch and show depths.

GROUND LEVEL

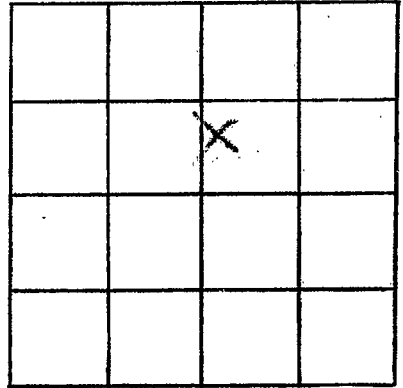

SECTION 18

Please indicate well location X.

ADDITIONAL INFORMATION

If more than one screen,
show locations of each on sketch.