

MISSISSIPPI DEPARTMENT OF NATURAL RESOURCES

Bureau of Land and Water Resources

Southport Mall

P.O. Box 10631

CODED

Jackson, Mississippi 39209

WATER WELL DRILLERS LOG

Tallahatchie  
J 88  
7/10/84

July 10 1984 date well completed  
LEEPER Drilling firm name  
Tallahatchie county well located

LANDOWNER: Claslie Meek  
Beard Plantation  
WEBB, MS.  
(mailing address)

description of formations encountered	from	to
TOP CLAY	0	12
fine sand	12	40
COARSE SAND and gravel	40	105

WELL LOCATION:  
sec. 26 T. 24 N. R. 1 E. S. 5  
3 miles EAST of WEBB  
(distance) (direction) (nearest town)

WELL PURPOSE: irrigation  
(home, irrigation, municipal, industrial)


- WELL COMPLETION DATA:
- (1) diameter (inches) 12"
  - (2) total depth (feet) 105
  - (3) static water level (feet) 10 below top of ground.
  - (4) casing PVC, 65' (material) (depth)  
12" (size) if telescope see back.
  - (5) screen 40', 65' (length) (depth to top)  
12" (size), PVC (material)
  - (6) pump 110 (HP), 1500 (yield gpm)  
Diesel (type, power)
  - (7) electric log NO (yes or no)  
(organization running log)
  - (8) how well bottom plugged CAP

CODED
DEPT. OF NATURAL RESOURCES BUREAU OF LAND & WATER RESOURCES
AUG 3 1984
<b>RECEIVED</b>

DRILLERS REMARKS:

If well telescopes please sketch and show depths.

GROUND LEVEL

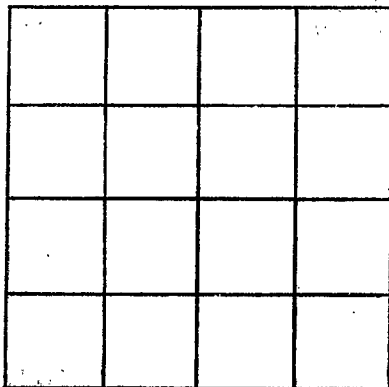

SECTION \_\_\_\_\_

Please indicate well location X.

ADDITIONAL INFORMATION

If more than one screen,  
show locations of each on sketch.