

MISSISSIPPI DEPARTMENT OF NATURAL RESOURCES

Bureau of Land and Water Resources

Southport Mall

P.O. Box 10631

CODED

Jackson, Mississippi 39209

WATER WELL DRILLERS LOG

Tallahatchie
J 89
8/9/84

July 9 1984 Leeper Drilling TALLAHATCHIE
date well completed firm name county well located

LANDOWNER: CARLITE MEER Bend PLANTATION	description of formations encountered	from	to
WEBB MS. (mailing address)	TOP CLAY	0	12
WELL LOCATION: sec. 23 T-24(N) S R-1 E (W) 3 miles EAST of WEBB (distance) (direction) (nearest town)	FINE SAND	12	40
WELL PURPOSE: irrigation (home, irrigation, municipal, industrial)	COARSE SAND and GRAVEL	40	195
WELL COMPLETION DATA:	CODED		
(1) diameter (inches) 12			
(2) total depth (feet) 105			
(3) static water level (feet) 10 (below top of ground)			
(4) casing PVC 65 (material) (depth)			
12" If telescope see back. (size)			
(5) screen 40' 65' (length) (depth to top)			
12" PVC (size) (material)			
(6) pump 110 1500 (HP) (yield gpm)			
Diesel (type power)			
(7) electric log (yes or no)			
(organization running log)			
(8) how well bottom plugged CA			

DEPT. OF NATURAL RESOURCES
BUREAU OF LAND & WATER RESOURCES


AUG 3 1984

RECEIVED

DRILLERS REMARKS:

If well telescopes please sketch and show depths.

GROUND LEVEL

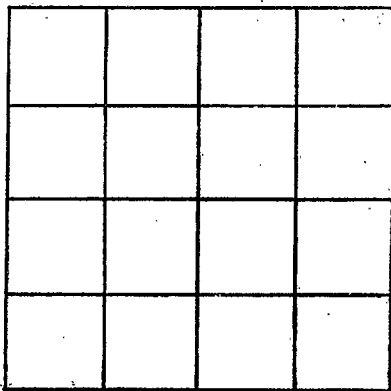

SECTION _____

Please indicate well location X.

ADDITIONAL INFORMATION

If more than one screen,
show locations of each on sketch.