

MISSISSIPPI DEPARTMENT OF NATURAL RESOURCES

Bureau of Land and Water Resources

Southport Mall

P.O. Box 10631

Jackson, Mississippi 39209

WATER WELL DRILLERS LOG

CODED

Tallahatchie
~~76~~ 590
 7/23/84

BUTANE GAS COMPANY

Tallahatchie

7-23 1984
 date well completed

OF GREENWOOD

county well located

LANDOWNER: Bee Pearson

description of formations encountered

from to

Rainbow Pt

clay

0 10

sand

10 65

peargravel

65 103

(mailing address)

WELL LOCATION:

sec. 18 T 24 N R 1 E
1.25 miles SE of Webb
 (distance) (direction) (nearest town)

WELL PURPOSE:
 (home, irrigation, municipal, industrial)

WELL COMPLETION DATA:

- (1) diameter (inches) 8"
- (2) total depth (feet) 103
- (3) static water level (feet) 30 below above top of ground.
- (4) casing Steel 63'
 (material) (depth)
8"
 (size) if telescope see back.
- (5) screen 40' 63'
 (length) (depth to top)
8" steel
 (size) (material)
- (6) pump 10 500
 (HP) (yield gpm)
Elect
 (type power)
- (7) electric log No
 (yes or no)
No
 (organization running log)
- (8) how well bottom plugged
Steel plate

CODED

DEPT. OF NATURAL RESOURCES
 BUREAU OF LAND & WATER RESOURCES

AUG 6 1984


RECEIVED

DRILLERS REMARKS:

Richard

If well telescopes please sketch and show depths.

GROUND LEVEL

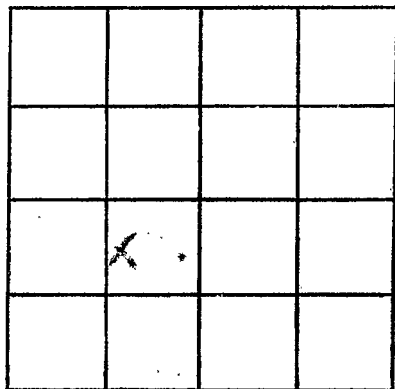

SECTION 18

Please indicate well location X.

ADDITIONAL INFORMATION

If more than one screen,
show locations of each on sketch.