

MISSISSIPPI DEPARTMENT OF NATURAL RESOURCES  
 Bureau of Land and Water Resources  
 Southport Mall  
 P.O. Box 10631  
 Jackson, Mississippi 39209  
**WATER WELL DRILLERS LOG**

**CODED**


Tallahatchie  
J911

3-9 1986 Dyer Well, Inc Tallahatchie  
 date well completed firm name county well located

LANDOWNER: <u>William Falls</u> <u>Box 552</u>	description of formations encountered	from	to
<u>Webb, Ms. 38966</u> (mailing address)	<u>Clay</u>	<u>0</u>	<u>28</u>
WELL LOCATION: sec. <u>30</u> T <u>24</u> (N) S R <u>1</u> E (W)	<u>fine sand</u>	<u>28</u>	<u>36</u>
<u>1/2</u> miles <u>S</u> of <u>Webb</u> (distance) (direction) (nearest town)	<u>sand</u>	<u>36</u>	<u>48</u>
WELL PURPOSE: <u>domestic</u> (home, irrigation, municipal, industrial)	<u>sand &amp; gravel</u>	<u>48</u>	<u>100</u>
WELL COMPLETION DATA:	<b>CODED</b>		
(1) diameter (inches) <u>16"</u>			
(2) total depth (feet) <u>100'</u>			
(3) static water level (feet) _____ below above top of ground.			
(4) casing <u>steel</u> , <u>60'</u> , (material) (depth)			
_____ if telescope see back. (size)			
(5) screen <u>40'</u> , <u>60'</u> (length) (depth to top)			
<u>16"</u> , <u>steel</u> (size) (material)			
(6) pump <u>60</u> <u>1150</u> (HP) (yield gpm)			
<u>Diesel</u> (type power)			
(7) electric log <u>no</u> (yes or no)			
_____ (organization running log)			
(8) how well bottom plugged <u>Steel Plate</u>			
DRILLERS REMARKS: _____			
_____			
_____			

If well telescopes please sketch and show depths.

GROUND LEVEL

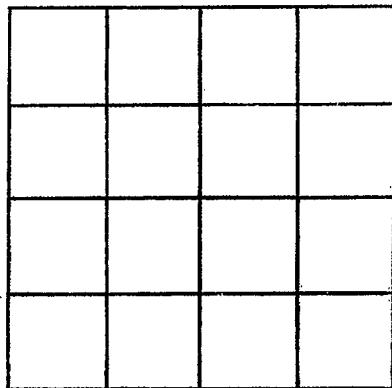

SECTION \_\_\_\_\_

Please indicate well location X.

ADDITIONAL INFORMATION

If more than one screen, show locations of each on sketch.