

MISSISSIPPI DEPARTMENT OF NATURAL RESOURCES

Bureau of Land and Water Resources

Southport Mall

P.O. Box 10631

Jackson, Mississippi 39209

WATER WELL DRILLERS LOG

Tallahatchie  
 292

CODED.

3-8 1985  
 date well completed

Dyer Well, Inc.  
 firm name

Tallahatchie  
 county well located

LANDOWNER: Williams Falls  
 Box 552  
 Webb, Ms. 38966  
 (mailing address)

description of formations encountered

from

to

Clay	0	30
Finest Sand	30	38
Sand	38	48
Sand + Gravel	48	113

WELL LOCATION:

sec. 30 T 24(N) R 1 E  
 1 1/2 miles S of Webb  
 (distance) (direction) (nearest town)

WELL PURPOSE: Irrigation  
 (home, irrigation, municipal, industrial)

WELL COMPLETION DATA:

- (1) diameter (inches) 16"
- (2) total depth (feet) 113
- (3) static water level (feet) \_\_\_\_\_ below/above top of ground.
- (4) casing Steel (material), 73' (depth)
- \_\_\_\_\_ if telescope see back. (size)
- (5) screen 40' (length), 73' (depth to top)
- 16" (size), Steel (material)
- (6) pump 60 (HP), 1100 (yield gpm)
- Diesel (type power)
- (7) electric log No (yes or no)

CODED


(organization running log)

(8) how well bottom plugged Steel Plate

DRILLERS REMARKS:

If well telescopes please sketch and show depths.

GROUND LEVEL

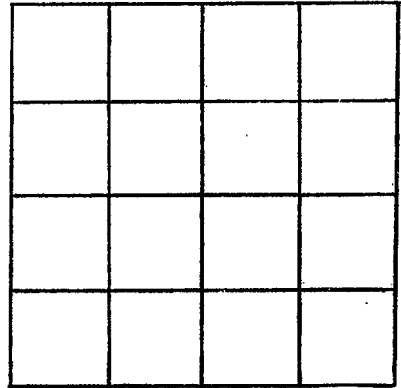

SECTION \_\_\_\_\_

Please indicate well location X.

ADDITIONAL INFORMATION

If more than one screen, show locations of each on sketch.