

MISSISSIPPI DEPARTMENT OF NATURAL RESOURCES

Bureau of Land and Water Resources

Southport Mall

P.O. Box 10631

Jackson, Mississippi 39209

WATER WELL DRILLERS LOG

TALLAHATCHIE
~~XXXX~~
 22-3749 *J99*
 GW15897

Coded
for D Point 8/02

2-25 19 87 LAYNE-CENTRAL CO. TALLAHATCHIE
 date well completed firm name county well located

LANDOWNER:
 WEST TALLAHATCHIE WATER ASN.

WEBB, MS
 (mailing address)

WELL LOCATION:
 sec. 24T-24N R-2W
19 8
 1 miles SOUTH of WEBB
 (distance) (direction) (nearest town)

WELL PURPOSE: MUNICIPAL
 (home, irrigation, municipal, industrial)

WELL COMPLETION DATA:

- (1) diameter (inches) 8"
- (2) total depth (feet) 894'
- (3) static water level (feet) 19' below top of ground.
- (4) casing STEEL, 853'
 (material) (depth)
8" if telescope see back.
 (size)
- (5) screen 35', 853'
 (length) (depth to top)
4", ST. STEEL
 (size) (material)
- (6) pump 15 150
 (HP) (yield gpm)
ELECTRIC
 (type power)
- (7) electric log YES
 (yes or no)
LAYNE-GEOLOGICAL SERVICE
 (organization running log)
- (8) how well bottom plugged ST. PLATE

description of formations encountered	from	to
SANDY CLAY	0	7
SOFT CLAY	7	37
CLAY	37	58
COARSE SAND	58	95
COARSE SAND & P/GRAVEL	95	115
GRAVEL	115	136
HARD CLAY	136	274
STKS.OF SAND & CLAY	274	322
SAND	322	359
STKS.OF SAND & CLAY	359	436
ROCK	436	437
CLAY	437	439
STKS.OF SAND & CLAY	439	463
ROCK	463	464
STKS.OF SAND & CLAY	464	471
ROCK	471	473
STKS.OF SAND & CLAY	473	498
ROCK	498	499
SHALE	499	581
ROCK	581	583
SHALE	583	637
HARD CLAY	637	690
SANDY SHALE	690	730
FINE SAND	730	737
SHALE & STKS.OF SAND	737	752
CLAY	752	761
SAND & STKS.OF SHALE	761	770
SAND	770	818
CLAY	818	860
SAND	860	891
CLAY	891	11905

DEC 11 1981
11905


FER 01 1988

Department of Natural Resources
 Bureau of Land & Water Resources

DRILLERS REMARKS:
MUX
680013-01

If well telescopes please sketch and show depths.

GROUND LEVEL

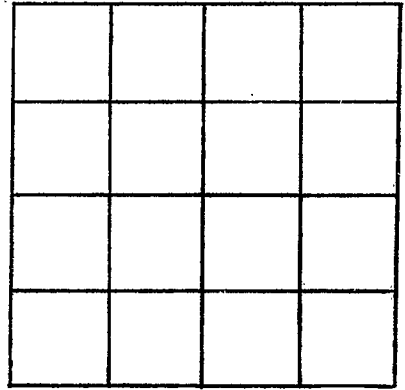

SECTION _____

Please indicate well location X.

ADDITIONAL INFORMATION

If more than one screen,
show locations of each on sketch.