

	4/13 State Well Report Part 1	For Office Use Only:
County: Tallahatchie	Mississippi Department of Environmental Qu	ality Aquifer:
Permit #:	Office of Land and Water Resources	Well #: <u>J-110</u>
Driller: Willie Bryant	P.O. Box 10631 Jackson, MS 39289-0631	
Date drilling completed: 12-3-05	(601)961-5210	L. S. Elevation:
	(601)354-6938 (fax)	E-log #:
State Law requires that this rep	oort be prepared by the driller in detail and f	iled with the Department within
30 days of completion of drilling	g of the well.	
Well Owner Informs		Well Location
Owner Name J. G. Flau		4914" Longitude: 090 • 15 · 97
Mailing Address: P. O. BOX	335 Method of Lat/Long (ci	39 rcle one): Conventional Survey, 58
•		id-held GPS Survey-grade GPS
Sum La Va		14 Twn 24 N Rng 1 W
<u>Siran Lake</u> City Sta	ate Zip Code	
Telephone No. ()	Distance Direc	tion Nearest Town
100 phone 110. ()		
	Well Data	
Purpose of Well (circle one) Home Ind	dustrial Public Supply Irrigation Fish Cult	ure Other:
	5 Date well drilling completed:	
Date wen unning starten: <u>12 3 05</u>	Date well drilling completed:	12 5 05
If flowing, method of flow regulation: Va	lve Other (describe)	
Static Water Level: 12' feet at	bove or below (circle one) land surface Date meas	sured: 12-3-05
		_
Method of Measurement (circle one) si	• •	rope + weight
	steel tape electric tape air line other: spth: <u>/00</u> Well grouted to a dep	rope + weight
		rope + weight
Hole depth: <u>/DD</u> Well de Type of grout (circle one): Cement	Bentonite Mix	th of <u>10</u> feet
Hole depth: <u>/DD</u> Well de Type of grout (circle one): Cement Casing length: <u></u> feet Casi	epth: <u>100</u> Well grouted to a dep Bentonite Mix ing diameter: <u>4</u> inches Type of case	th of <u>10</u> feet
Hole depth: <u>/DD</u> Well de Type of grout (circle one): Cement Casing length: <u></u> feet Casi	Bentonite Mix	th of <u>10</u> feet
Hole depth: <u>/00</u> Well de Type of grout (circle one): Cement Casing length: <u>90</u> feet Casi Screen length: <u>10</u> feet Scree	epth: <u>100</u> Well grouted to a dep Bentonite Mix ing diameter: <u>4</u> inches Type of case	$rope \neq Weight$ th of feet sing: $PVC / 60$ een: <u>SCH 40</u>
Hole depth: <u>/DD</u> Well de Type of grout (circle one): Cement Casing length: <u>90</u> feet Casi Screen length: <u>10</u> feet Scree Screen slot size: <u>0/3</u> inches	een diameter: <u>4</u> inches Type of cas Setting depth: From <u>90</u> feet to	rope + Weight th of feet sing: $PVC / 60$ een: $SCH 40$ feet
Hole depth: <u>/DD</u> Well de Type of grout (circle one): Cement Casing length: <u>90</u> feet Casi Screen length: <u>10</u> feet Scree Screen slot size: <u>0/3</u> inches	epth: <u>100</u> Well grouted to a dep Bentonite Mix ing diameter: <u>4</u> inches Type of cas een diameter: <u>4</u> inches Type of scr Setting depth: From <u>90</u> feet to Gravel packed Underreamed Telescoped	$rope + Weight$ th of feet sing: $\underline{PVC} \ 160$ een: $\underline{SCH} \ 40$ feet Open hole Natural Development
Hole depth: <u>/DD</u> Well de Type of grout (circle one): Cement Casing length: <u>90</u> feet Casi Screen length: <u>10</u> feet Scree Screen slot size: <u>0/3</u> inches	een diameter: <u>4</u> inches Type of cas Setting depth: From <u>90</u> feet to	$rope + Weight$ th of feet sing: $\underline{PVC} \ 160$ een: $\underline{SCH} \ 40$ feet Open hole Natural Development
Hole depth: <u>100</u> Well de Type of grout (circle one): Cement Casing length: <u>90</u> feet Casi Screen length: <u>10</u> feet Scree Screen slot size: <u>0/3</u> inches	epth: <u>100</u> Well grouted to a dep Bentonite Mix ing diameter: <u>4</u> inches Type of cas een diameter: <u>4</u> inches Type of scru- Setting depth: From <u>90</u> feet to Gravel packed Underreamed Telescoped Other (describe):	$rope + Weight$ th of feet sing: $\underline{PVC} \ 160$ een: $\underline{SCH} \ 40$ feet Open hole Natural Development
Hole depth: <u>100</u> Well de Type of grout (circle one): Cement Casing length: <u>90</u> feet Casi Screen length: <u>10</u> feet Scree Screen slot size: <u>0/3</u> inches Type of completion (circle all applicable): Top of lap pipe or reduction in casing:	epth: <u>100</u> Well grouted to a dep Bentonite Mix ing diameter: <u>4</u> inches Type of cas een diameter: <u>4</u> inches Type of scru- Setting depth: From <u>90</u> feet to Gravel packed Underreamed Telescoped Other (describe):	$rope + Weight$ th of feet sing: $\underline{PVC} / 60$ een: $\underline{SCH} 40$ feet Open hole Natural Development ne screen, describe on back of page
Hole depth: <u>/DD</u> Well de Type of grout (circle one): Cement Casing length: <u>/D</u> feet Casi Screen length: <u>/D</u> feet Scree Screen slot size: <u>0/3</u> inches Type of completion (circle all applicable): Top of lap pipe or reduction in casing: <u></u> Logs run (circle all applicable): No log ru	spth: 100' Well grouted to a dep Bentonite Mix ing diameter: 4 inches Type of cas een diameter: 4 inches Type of scr Setting depth: From 90 feet to Gravel packed Underreamed Telescoped Other (describe):	$rope + Weight$ th of feet sing: $\underline{PVC 160}$ een: $\underline{SCH 440}$ feet Open hole Natural Development ne screen, describe on back of page tron Other:
Hole depth: <u>/DD</u> Well de Type of grout (circle one): Cement Casing length: <u>/D</u> feet Casi Screen length: <u>/D</u> feet Scree Screen slot size: <u>0/3</u> inches Type of completion (circle all applicable): Top of lap pipe or reduction in casing: <u></u> Logs run (circle all applicable): No log ru	spth: 100' Well grouted to a dep Bentonite Mix ing diameter: 4 inches Type of cas een diameter: 4 inches Type of scr Setting depth: From 90 feet to Gravel packed Underreamed Telescoped Other (describe):	$rope + Weight$ th of feet sing: $\underline{PVC 160}$ een: $\underline{SCH 440}$ feet Open hole Natural Development ne screen, describe on back of page tron Other:
Hole depth: <u>/DD</u> Well de Type of grout (circle one): Cement Casing length: <u></u> feet Casi Screen length: <u></u> feet Scree Screen slot size: <u></u> 0/3inches Type of completion (circle all applicable): Top of lap pipe or reduction in casing: Logs run (circle all applicable): No log ru Name of organization running log(s): I certify that the well was drilled, constr	spth: 100' Well grouted to a dep Bentonite Mix ing diameter: 4 inches Type of cas een diameter: 4 inches Type of scr Setting depth: From 90 feet to Gravel packed Underreamed Telescoped Other (describe):	rope \downarrow \bigcirc \bigcirc \bigcirc \bigcirc \bigcirc \bigcirc th of \bigcirc \bigcirc feet sing: \bigcirc
Hole depth: <u>/DD</u> Well de Type of grout (circle one): Cement Casing length: <u>/D</u> feet Casi Screen length: <u>/D</u> feet Scree Screen slot size: <u>0/3</u> inches Type of completion (circle all applicable): Top of lap pipe or reduction in casing: <u></u> Logs run (circle all applicable): No log ru Name of organization running log(s): <u></u> I certify that the well was drilled, constr Department of Environmental Quality a	spth: 100' Well grouted to a dep Bentonite Mix ing diameter: 4 inches Type of cas een diameter: 4 inches Type of scr Setting depth: From 90 feet to Setting depth: From 90 feet to Gravel packed Underreamed Telescoped Other (describe):	rope \downarrow \bigcirc \bigcirc \bigcirc \bigcirc \bigcirc th of \square feet sing: $\square \lor \square$ \square
Hole depth: <u>/DD</u> Well de Type of grout (circle one): Cement Casing length: <u></u> feet Casi Screen length: <u></u> feet Scree Screen slot size: <u></u> 0/3inches Type of completion (circle all applicable): Top of lap pipe or reduction in casing: Logs run (circle all applicable): No log ru Name of organization running log(s): I certify that the well was drilled, constr	spth: 100' Well grouted to a dep Bentonite Mix ing diameter: 4 inches Type of cas een diameter: 4 inches Type of scr Setting depth: From 90 feet to Setting depth: From 90 feet to Gravel packed Underreamed Telescoped Other (describe):	rope \downarrow \bigcirc \bigcirc \bigcirc \bigcirc \bigcirc \bigcirc th of \bigcirc \bigcirc feet sing: \bigcirc
Hole depth: <u>/DD</u> Well de Type of grout (circle one): Cement Casing length: <u>/D</u> feet Casi Screen length: <u>/D</u> feet Scree Screen slot size: <u>0/3</u> inches Type of completion (circle all applicable): Top of lap pipe or reduction in casing: <u></u> Logs run (circle all applicable): No log ru Name of organization running log(s): <u></u> I certify that the well was drilled, constr Department of Environmental Quality a	spth: $100'$ Well grouted to a dep Bentonite Mix ing diameter: 4 inches Type of case een diameter: 4 inches Type of screened Setting depth: From 90 feet to Setting depth: From 90 feet to Gravel packed Underreamed Telescoped Other (describe):	rope \downarrow \bigcirc \bigcirc \bigcirc \bigcirc \bigcirc th of \square feet sing: $\square \lor \square$ \square
Hole depth: 100^{\prime} Well de Type of grout (circle one): Cement Casing length: 90^{\prime} feet Casi Screen length: 10^{\prime} feet Scree Screen slot size: $0/3^{\prime}$ inches Type of completion (circle all applicable): Top of lap pipe or reduction in casing: Logs run (circle all applicable): No log ru Name of organization running log(s): I certify that the well was drilled, constr Department of Environmental Quality a Willie L. Bryant	spth: $100'$ Well grouted to a dep Bentonite Mix ing diameter: 4 inches Type of case een diameter: 4 inches Type of screened Setting depth: From 90 feet to Setting depth: From 90 feet to Gravel packed Underreamed Telescoped Other (describe):	rope + $Weight$ th of feet sing: $PVC / 60$ een: $SCH 40$ feet Open hole Natural Development me screen, describe on back of page tron Other: icable requirements of the Mississip lations and state laws. Wo E Buyen t ture of Water Weil Contractor
Hole depth: <u>/DO</u> Well de Type of grout (circle one): Cement Casing length: <u>/O</u> feet Casi Screen length: <u>/D</u> feet Scree Screen slot size: <u>0/3</u> inches Type of completion (circle all applicable): Top of lap pipe or reduction in casing: <u></u> Logs run (circle all applicable): No log ru Name of organization running log(s): <u></u> I certify that the well was drilled, constr Department of Environmental Quality a Willie L. Bryant	epth: $100'$ Well grouted to a depter the second sec	rope \downarrow Weight th of

If well telescopes please sketch below and show depths.

Ground Level

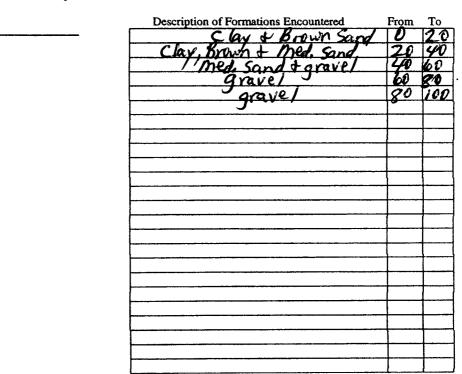

If more than one screen, show location of each on sketch

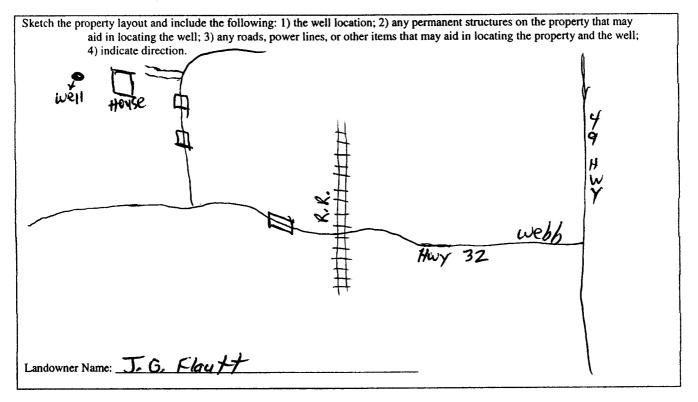

Willy L. Bujan Signature of Water Well Contractor

DEL 2 0 2005 BYOLWB

RECEIVED

J-110