

Tallahatchie
 J 2000
 8-66

MISSISSIPPI BOARD OF WATER COMMISSIONERS

WATER WELL DRILLERS LOG

Date: Aug 8, 1966, Driller: DELTA DRILLING Co. County: TALLAHATCHIE
 (Name)

(1) Owner of Land: MRS. WHITNEY E. SMITH
 (Name)
WEBB, MISS.
 (Address)

(2) Location: 3W 1/4, 5W 1/4, Sec. 29 T24R1W
1 1/4 miles S of Webb
 (distance) (direction) (Nearest Town)

(3) Topography: FLAT
 (Hilly) (Flat) (Level)

(4) Purpose of Well: DOMESTIC
 (Domestic Irrigation
 Municipal, Industrial, Other)

Description & Color of Materials Sand, Clay, Red Clay, Shell, etc.	Thick- ness Feet	Depth Feet
TOP SOIL + Gumbo -	26	26
Sand	60	86
Gravel	63	149
gumbo w/Rocks -	123	272
Shale	50	322
Sand	30	352
Shale w/Rocks	104	456
Green Shale w/Rocks	40	496
green sand w/Rocks	82	578
green shale w/Rocks	94	672
Sand	28	700
Shale	60	760
Sand	52	812
Shale	18	830
Sand	54	884
Shale	38	922
Sand	16	928
Shale	6	932
Sand	12	944
Shale	4	948

Information upon completion of well:

(1) Diameter 4 inches.
~~3~~

(2) Total Depth 948 feet.

(3) Water Level FLows feet below top of ground.


(4) Cased to 928, Size 4 1/2" - 2"
^{100' - 4"}
^{400' - 3"}

(5) Screen: Size 2", Length 20'

(6) Were any formations sealed against pollution?
 yes, no.

If YES depth of formation 500'
To seal OFF SURFACE
 Why Formation

Drillers Remarks: 24' LAP OF 2" IN
3" PIPE

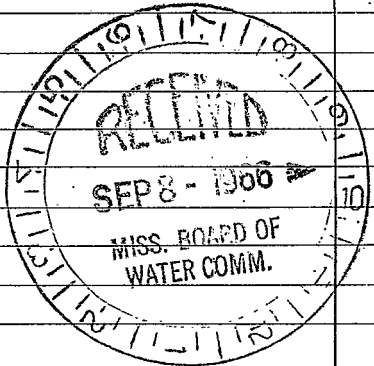

(Use Back Side)

Well No.

