

Jalalath
J 2007

MISSISSIPPI DEPARTMENT OF NATURAL RESOURCES
Bureau of Land and Water Resources
Southport Mall
P.O. Box 10631
Jackson, Mississippi 39209

WATER WELL DRILLERS LOG

83 BUTANE GAS COMPANY
OF GREENWOOD
firm name

1-14 1982
date well completed

Jalalath
county well located

LANDOWNER:	description of formations encountered	from	to
<i>Mike Huskins</i>	<i>Clay</i>	<i>0</i>	<i>10</i>
	<i>sand</i>	<i>10</i>	<i>30</i>
(mailing address)	<i>sand & gravel</i>	<i>30</i>	<i>103</i>
WELL LOCATION:			
sec. <i>6</i> T. <i>24</i> N. R. <i>1</i>			
<i>2.14</i> miles <i>E</i> of <i>Sumner</i>			
(distance) (direction) (nearest town)			
WELL PURPOSE: (home, irrigation, municipal, industrial)			
WELL COMPLETION DATA:			
(1) diameter (inches) <i>16"</i>			
(2) total depth (feet) <i>103'</i>			
(3) static water level (feet) <i>17</i> <small>below above</small> top of ground.			
(4) casing <i>Steel</i> , <i>63'</i> (material) (depth)			
<i>16"</i> if telescope see back. (size)			
(5) screen <i>40</i> , <i>63'</i> (length) (depth to top)			
<i>16"</i> , <i>Steel</i> (size) (material)			
(6) pump <i>6095</i> <i>1900</i> (HP) (yield gpm)			
<i>Diesel</i> (type power)			
(7) electric log <i>No</i> (yes or no)			
<i>No</i> (organization running log)			
(8) how well bottom plugged <i>Steel plate</i>			

DEPT. OF NATURAL RESOURCES
BUREAU OF LAND & WATER RESOURCES


JAN 17 1983

RECEIVED

DRILLERS REMARKS:
Carlin Ramon

If well telescopes please sketch and show depths.

GROUND LEVEL

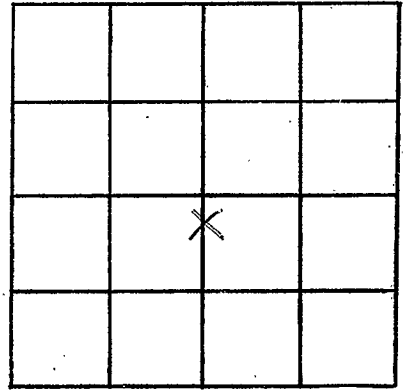

SECTION 6

Please indicate well location X.

ADDITIONAL INFORMATION

If more than one screen,
show locations of each on sketch.