

MISSISSIPPI DEPARTMENT OF NATURAL RESOURCES

Bureau of Land and Water Resources

Southport Mall

P.O. Box 10631

Jackson, Mississippi 39209

WATER WELL DRILLERS LOG

BUTANE GAS COMPANY

OF GREENWOOD

TALAHATCHIE

Tallahatchie
J 2008

12-10 1982
 date well completed

firm name

county well located

LANDOWNER:	description of formations encountered	from	to
<u>Mike Sturdivant</u> (mailing address)	<u>Clay</u> <u>Sand</u> <u>Sand & gravel</u>	<u>0</u> <u>20</u> <u>40</u>	<u>20</u> <u>40</u> <u>105</u>
WELL LOCATION: sec. <u>7</u> T <u>24</u> N R. <u>1</u> W <u>2.5</u> miles <u>E</u> of <u>Summer</u> (distance) (direction) (nearest town)			
WELL PURPOSE: <u>Municipal</u> (home, irrigation, municipal, industrial)			
WELL COMPLETION DATA:			
(1) diameter (inches) <u>16"</u>			
(2) total depth (feet) <u>105</u>			
(3) static water level (feet) _____ below above top of ground.			
(4) casing <u>Steel</u> , <u>65</u> , (material) (depth) <u>16"</u> If telescope see back. (size)			
(5) screen <u>40</u> , <u>65</u> (length) (depth to top) <u>16"</u> , <u>Steel</u> (size) (material)			
(6) pump <u>60</u> <u>1500</u> (HP) (yield gpm) <u>Diesel</u> (type power)			
(7) electric log <u>No</u> (yes or no) <u>No</u> (organization running log)			
(8) how well bottom plugged <u>Steel plate</u>			
DRILLERS REMARKS: <u>Charles Riano</u>			


MISSISSIPPI DEPARTMENT OF NATURAL RESOURCES
 BUREAU OF LAND & WATER RESOURCES

JAN 17 1983

RECEIVED

If well telescopes please sketch and show depths.

GROUND LEVEL

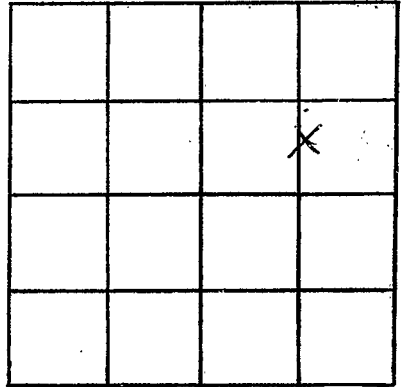

SECTION 7

Please indicate well location X.

ADDITIONAL INFORMATION

If more than one screen,
show locations of each on sketch.