

MISSISSIPPI DEPARTMENT OF NATURAL RESOURCES

Bureau of Land and Water Resources

Southport Mall

P.O. Box 10631

Jackson, Mississippi 39209

WATER WELL DRILLERS LOG

BUTANE GAS COMPANY

OF GREENWOOD

Talabatchie
J 2009

Talabatchie
county well located

12-23 1982
date well completed

LANDOWNER:	description of formations encountered	from	to
Mike Sturdivant	Clay	6	20
(mailing address)	SAND	20	40
WELL LOCATION:	sand & gravel	40	105
sec. 7 T44N R. 1 E 8			
(distance) miles (direction) of (nearest town)			
WELL PURPOSE: irrigation (home, irrigation, municipal, industrial)			
WELL COMPLETION DATA:			
(1) diameter (inches) 16"			
(2) total depth (feet) 105			
(3) static water level (feet) ? below top of ground.			
(4) casing Steel, 65 (material) (depth) 16 (size) if telescope see back.			
(5) screen 40 (length), 65 (depth to top)			
(6) pump 16" (size), steel (material)			
(6) pump 60 (HP), 1500 (yield gpm)			
Diesel (type power)			
(7) electric log No (yes or no)			
(organization running log) No			
(8) how well bottom plugged steel plate			
DRILLERS REMARKS: Carlos Ramos			


DEPT. OF NATURAL RESOURCES
BUREAU OF LAND & WATER RESOURCES

JAN 17 1983

RECEIVED

If well telescopes please sketch and show depths.

GROUND LEVEL

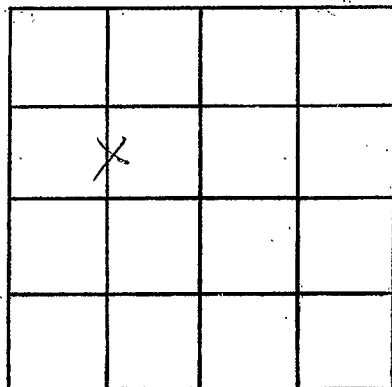

SECTION 7

Please indicate well location X.

ADDITIONAL INFORMATION

If more than one screen,
show locations of each on sketch.