


K9

WATER WELL DRILLERS LOG

CODED

Date: 1965, Driller: James Q. Lipe County Saladatchia
(Name)

	Description & Color of Materials Sand, Clay, Red Clay, Shell, etc.	Thick- ness Feet	Depth Feet
(1) Owner of Land: <u>L. L. Laymon</u> <small>(Name)</small> <small>(Address)</small>	<u>water sand</u> <u>11 11</u>	<u>643</u> <u>663</u>	<u>663</u> <u>674</u>
(2) Location: <u>1/4</u> , <u>1/4</u> , Sec. <u>T</u> <u>R</u> , <u> </u> miles <u> </u> of <u> </u> , <small>(distance)</small> <small>(direction)</small> <small>(Nearest Town)</small>			
(3) Topography: <u> </u> <small>(Hilly)</small> <small>(Flat)</small> <small>(Level)</small>			
(4) Purpose of Well: <u> </u> <small>(Domestic Irrigation Municipal, Industrial, Other)</small>			
Information upon completion of well:			
(1) Diameter <u> </u> inches.			
(2) Total Depth <u> </u> feet.			
(3) Water Level <u> </u> feet below top of ground.			
(4) Cased to <u> </u> , Size <u> </u> ,			
(5) Screen: Size <u> </u> , Length <u> </u> .			
(6) Were any formations sealed against pollution? <u> </u> yes, <u> </u> no.			
If YES depth of formation <u> </u> ,			
Why <u> </u>			
Drillers Remarks: <u> </u>			

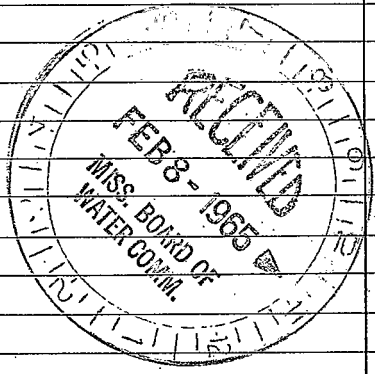

(Use Back Side)

Well No.

