

Tallahatchie
K 11
5-29-70

MISSISSIPPI
BOARD OF WATER COMMISSIONERS
416 North State Street
Jackson, Mississippi 39201

CODED

WATER WELL DRILLERS LOG

5.29 1970 James R. Lipe Tallahatchie
date well completed firm name county well located

LANDOWNER: Mr. Davis

description of formations encountered

from to

TIPPO Miss.
(mailing address)

WELL LOCATION:

sec. 27 T-24 N R-1 E
2 miles south of TIPPO
(distance) (direction) (nearest town)

WELL PURPOSE: HOME
(home, irrigation, municipal, industrial)

WELL COMPLETION DATA:

- (1) diameter (inches) 2
- (2) total depth (feet) 629
- (3) static water level (feet) 0 below above top of ground.
- (4) casing galv. 599
(material) (depth)
2 If telescope see back.
(size)
- (5) screen 30 699
(length) (depth to top)
2 galv.
(size) (material)
- (6) pump none 30
(HP) (yield gpm)
no
(type power)
- (7) electric log no
(yes or no)
no
(organization running log)
- (8) how well bottom plugged galv. plug

description of formations encountered	from	to
Clay	0	20
sand	20	40
"	40	60
"	60	80
Gravel	80	100
"	100	120
Clay and sand	120	140
"	140	160
"	160	180
"	180	200
shale and sand	200	220
sand	220	240
"	240	260
sand and rocks	260	280
" " "	280	300
sand	300	320
"	320	340
sand and clay	340	360
" " "	360	380
" " "	380	400
good sand	400	420
" "	420	440
sand and clay	440	460
" " "	460	480
" " "	480	500
" " "	500	520
" " "	520	540
" " "	540	560
good sand	560	580
" "	580	600
" "	600	629

CODED


JUL 10 1970

DRILLERS REMARKS:

MISS. BD. OF
WATER COMM.

If well telescopes please sketch and show depths.

GROUND LEVEL

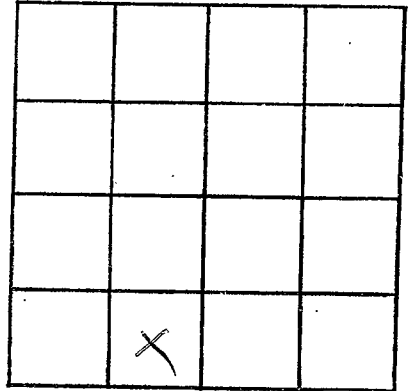

SECTION 27

Please indicate well location X.

ADDITIONAL INFORMATION

A series of horizontal lines for writing additional information, starting below the 'ADDITIONAL INFORMATION' header and extending to the bottom of the page.

If more than one screen, show locations of each on sketch.