

Tallahatchie
K 15
3-25-75

MISSISSIPPI
 BOARD OF WATER COMMISSIONERS
 416 North State Street
 Jackson, Mississippi 39201

CODED

WATER WELL DRILLERS LOG

3-25-75 19 BUTANE GAS CO. OF GREENWOOD Tallahatchie
 date well completed firm name county well located


LANDOWNER:	description of formations encountered	from	to
<u>B+S PLANTING Co.</u> <u>Glendora</u> (mailing address)			
WELL LOCATION:			
sec. <u>31</u> T. <u>24</u> N R. <u>1</u> E S <u>5</u> S <u>10</u>			
<u>3 1/2</u> miles <u>NE</u> of <u>Swan Lake</u> (distance) (direction) (nearest town)			
WELL PURPOSE: <u>FAR</u> (home, irrigation, municipal, industrial)			
WELL COMPLETION DATA:			
(1) diameter (inches) <u>16"</u>			
(2) total depth (feet) <u>105</u>			
(3) static water level (feet) <u>4</u> below/above top of ground.			
(4) casing <u>Steel</u> , <u>65</u> , (material) (depth) <u>16"</u> if telescope see back. (size)			
(5) screen <u>40</u> , <u>65</u> (length) (depth to top) <u>16"</u> , <u>Steel</u> (size) (material)			
(6) pump <u>60</u> <u>2500</u> (HP) (yield gpm) <u>Diesel</u> (type power)			
(7) electric log <u>NS</u> (yes or no)			
(organization running log)			
(8) how well bottom plugged <u>Steel plate</u>			
DRILLERS REMARKS:			

CODED

REGISTERED
APR 3 1975

If well telescopes please sketch and show depths.

GROUND LEVEL

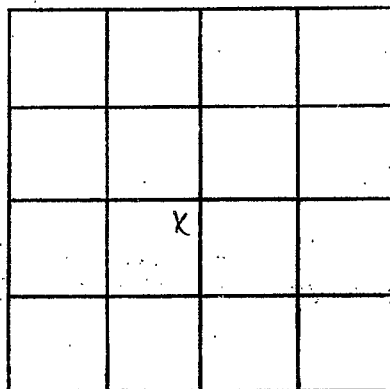

SECTION 31

Please indicate well location X.

ADDITIONAL INFORMATION

If more than one screen,
show locations of each on sketch.