

Tallahatchie

K 19

9-20-79

MISSISSIPPI BOARD OF WATER COMMISSIONERS  
416 North State Street  
Jackson, Mississippi 39201

CODED

WATER WELL DRILLERS LOG  
BUTANE GAS COMPANY

9-20-79 19  
date well completed

OF GREENWOOD

Tallahatchie  
county well located


| LANDOWNER:  | description of formations encountered | from | to |
|---|---------------------------------------|------|----|
| MURPHEY Plantation<br>Tippo<br>(mailing address)  |                                       |      |    |
| WELL LOCATION:<br>sec. <u>36</u> T <u>24</u> N R. <u>1</u> E<br>1 miles <u>E</u> of <u>Tippo</u><br>(distance) (direction) (nearest town) |                                       |      |    |
| WELL PURPOSE: <u>Home</u><br>(home, irrigation, municipal, industrial)  |                                       |      |    |
| WELL COMPLETION DATA:   |                                       |      |    |
| (1) diameter (inches) <u>4 X 2</u>  |                                       |      |    |
| (2) total depth (feet) <u>607</u>   |                                       |      |    |
| (3) static water level (feet) <u>0</u> below above top of ground.   |                                       |      |    |
| (4) casing <u>Steel</u> , <u>577</u> ,<br>(material) (depth)<br><u>4 X 2</u> If telescope see back.<br>(size)                             |                                       |      |    |
| (5) screen <u>30</u> , <u>577</u><br>(length) (depth to top)<br><u>2"</u> , <u>Stainless</u><br>(size) (material)                         |                                       |      |    |
| (6) pump <u>1</u> , <u>40</u><br>(HP) (yield gpm)<br><u>Elec.</u><br>(type power)   |                                       |      |    |
| (7) electric log <u>NO</u><br>(yes or no)<br><br>(organization running log)   |                                       |      |    |
| (8) how well bottom plugged<br><u>Back Pressure Valve</u>   |                                       |      |    |
| DRILLERS REMARKS:   |                                       |      |    |

CODED

Rec'd 9-24-79  
D.M.

If well telescopes please sketch and show depths.

GROUND LEVEL

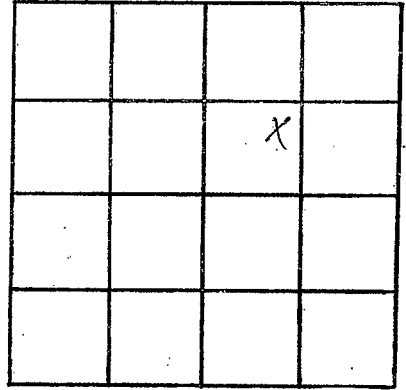

SECTION 36

Please indicate well location X.

ADDITIONAL INFORMATION

If more than one screen, show locations of each on sketch.