

MISSISSIPPI DEPARTMENT OF NATURAL RESOURCES

Bureau of Land and Water Resources

Southport Mall

P.O. Box 10631

Jackson, Mississippi 39209

WATER WELL DRILLERS LOG

CODED

Tallahatchie  
K. 24

6 1987 date well completed  
Powell Inc firm name  
Tallahatchie county well located

LANDOWNER:  
Smith Murphey  
Webb, MS 38966  
(mailing address)

description of formations encountered	from	to
Clay	0	23
Fine Sand	23	53
Shot up with blue Clay	53	83
GRAVEL & SAND	83	103
Boulders & Blue Clay		

WELL LOCATION:  
sec 21 24 N R 1 E  
2 miles SW of Webb  
(distance) (direction) (nearest town)

WELL PURPOSE: LUK  
(home, irrigation, municipal, industrial)

WELL COMPLETION DATA:

(1) diameter (inches) 16

(2) total depth (feet) 130

(3) static water level (feet) 20 below top of ground.

(4) casing Steel, 80 (material) (depth)

(size) if telescope see back.

(5) screen 50 80 (length) (depth to top)

16 Steel (size) (material)


(6) pump 300 3200 (HP) (yield gpm)

Diesel (type power)

(7) electric log (yes or no)

(organization running log)

(8) how well bottom plugged Steel Plate

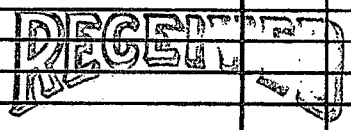


JUL 27 1987

Department of Natural Resources  
Bureau of Land & Water Resources

DRILLERS REMARKS:

If well telescopes please sketch and show depths.

GROUND LEVEL

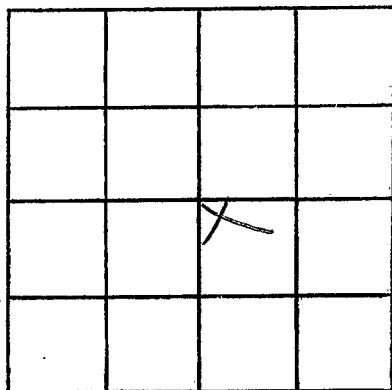

SECTION 21

Please indicate well location X.

ADDITIONAL INFORMATION

If more than one screen, show locations of each on sketch.