

MISSISSIPPI DEPARTMENT OF ENVIRONMENTAL QUALITY

Office of Land and Water Resources

P. O. Box 10631
Jackson, MS 39289-0631
WATER WELL DRILLERS LOG

COUNTY WELL LOCATED
TALLAHATCHIE

WELL NUMBER **K28** CODED

DATE WELL COMPLETED
6/12/95

PERMIT NUMBER

NAME OF DRILLING FIRM
LAYNE-CENTRAL

NAME & MAILING ADDRESS OF LANDOWNER
LACY MURPHY

P.O. BOX 36

TIPPO, MS 38962

WELL LOCATION: SEC **34** TOWNSHIP **24N** RANGE **N 1E W**

DISTANCE **1/4** Miles **SE** of **TIPPO**

OTHER LANDMARK

WELL PURPOSE: Home, Irrigation, Municipal, Industrial, Fish Pond, etc.
IRRIGATION

PUMP DATA

PUMP TYPE (Circle One):
Submersible, Turbine, Jet, Flowing Well,
Other (Describe) **SUBMERSIBLE**

POWER TYPE (Circle One):
Electric, Tractor, Diesel, Gasoline, Butane,
Other (Describe) **ELECTRIC H/P 10**

Pump Capacity (GPM) No. of Stages Setting Depth
1 65' FT.

PUMP TEST
Well yielded _____ GPM with
a drawdown of _____ ft.
after _____ hours of pumping

WELL DATA

Well Depth 95'	Casing Diameter (In.) 10"	Casing Length (Ft.) 55'
Type of Casing PVC	Hole Depth 95'	Depth to Static Water Level 12'

TYPE OF COMPLETION: (Circle One or More):
Gravel Packed, Underreamed, Telescoped,
Natural Development, Open Hole, Other
(Describe) **GRAVEL PACKED**

WELL GROUTED TO A DEPTH OF **10 FEET**
Type Grout (circle one): Cement, Bentonite, or Mix

LOG DATA

TYPE OF LOG RUN (Circle One): No Log Run,
Electric, Gamma Ray, Density, Sonic, Neutron,
Other (Describe) _____

Name of Organization Running Log

SCREEN DATA

Diameter - Inches 10"	Length - Feet 40'	Slot Size - Inches .050
Screen Type PVC	Depth to Bottom - Feet 95'	

GEOLOGIC DATA (Office Use Only)

Surface Elev.	Geologic Unit	Unit Thickness	Depth to Top
Subs. SWL	Date	Analysis	Aquifer Test

Driller's Remarks

Top of Lap Pipe or Reduction in Casing
DISCOVERED
IF TELESCOPED OR MORE THAN ONE SCREEN USE BACK PAGE

DESCRIPTION OF FORMATIONS ENCOUNTERED	FROM	TO
SAND	0	8
CLAY	8	18
BROWN SAND	18	35
COURSE SAND	35	50
COURSE SAND G.	50	95
CLAY	95	104


FORMATIONS (Continued)

FROM	TO
OCT 12 1995	
Dept. of Environmental Quality	
Office of Land & Water Resources	

IF MORE SPACE IS NEEDED, USE BACK

If well telescopes please sketch and show depths.

GROUND LEVEL

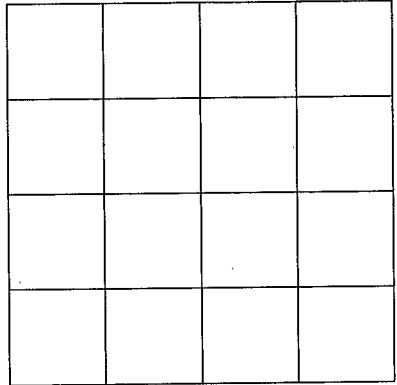

SECTION _____

Please indicate well location X.

ADDITIONAL INFORMATION

If more than one screen,
show location of each on sketch.