

MISSISSIPPI DEPARTMENT OF NATURAL RESOURCES

Bureau of Land and Water Resources

Southport Mall

P.O. Box 10631

Jackson, Mississippi 39209

WATER WELL DRILLERS LOG

CODED

TALLAHATCHIE
K59
6-20-83

6-20
date well completed

BUTANE GAS CO. OF GREENWOOD

firm name

Tallahatchie
county well located

LANDOWNER:	description of formations encountered	from	to
Ralph Wolfe Tippo (mailing address)			
WELL LOCATION: sec. <u>35</u> T. <u>24</u> N. R. <u>1</u> E. S. <u>8</u> W. <u>W</u>			
<u>2</u> miles <u>S.E.</u> of <u>Tippo</u> (distance) (direction) (nearest town)			
WELL PURPOSE: <u>min.</u> (home, irrigation, municipal, industrial)			
WELL COMPLETION DATA:			
(1) diameter (inches) <u>16"</u>			
(2) total depth (feet) <u>85</u>			
(3) static water level (feet) <u>5</u> <u>below</u> top of ground. <u>above</u>			
(4) casing <u>Steel, 45</u> (material) (depth)			
<u>16"</u> (size) if telescope see back.			
(5) screen <u>40'</u> , <u>45</u> (length) (depth to top)			
<u>16"</u> , <u>Steel</u> (size) (material)			
(6) pump <u>60</u> <u>2000</u> (HP) (yield gpm)			
<u>Diesel</u> (type power)			
(7) electric log <u>No</u> (yes or no)			
<u>No.</u> (organization running log)			
(8) how well bottom plugged <u>Steel plate</u>			
DRILLERS REMARKS: <u>Custer Run</u>			

CODED


DEPT. OF NATURAL RESOURCES
BUREAU OF LAND AND WATER RESOURCES

JUL 20 1983

RECEIVED

If well telescopes please sketch and show depths.

GROUND LEVEL

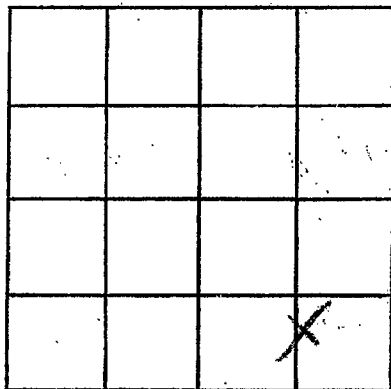

SECTION 35

Please indicate well location X.

ADDITIONAL INFORMATION

If more than one screen, show locations of each on sketch.